

## WATER SERVICE RECORD

Name Paul Furdon

Service No. 26.

Address 30 Fletcher Avenue

Location

~~Repair~~—Renewal—~~New Service~~ W.O. #3341.


Comm 7-28-75

Date	Material	Amount	Total	Date	Amount	
5-21-75	Labor	\$30.38		5-17-75	Deposit	500.00
	10% O.H.	3.04	\$ 33.42	7-28-75	<del>Deposit</del> Retard	110.34
	31' 3/4" Copper Pipe @1.01		31.31			89.66
	1 3/4" Wheel Valve		15.43		NON-CHARGE (OUTSIDE)	
	1 Hr. Trucking		3.00	5-21-75	Labor	\$ 28.25
	1 Hr. Backhoe		6.50		9' 3/4" Copper Pipe @1.01	9.09
			\$ 89.66		1 3/4" Curb Stop	14.40
					1 3/4" Adapter	5.72
					1 Hr. Trucking	3.00
					1 Hr. Backhoe	6.50
					1 Patch 5' x 6'	19.98
						\$ 86.94

DATE \_\_\_\_\_

TOWN OF LEXINGTON — BOARD OF PUBLIC WORKS  
**WATER DIVISION**

Sketch of Service Here

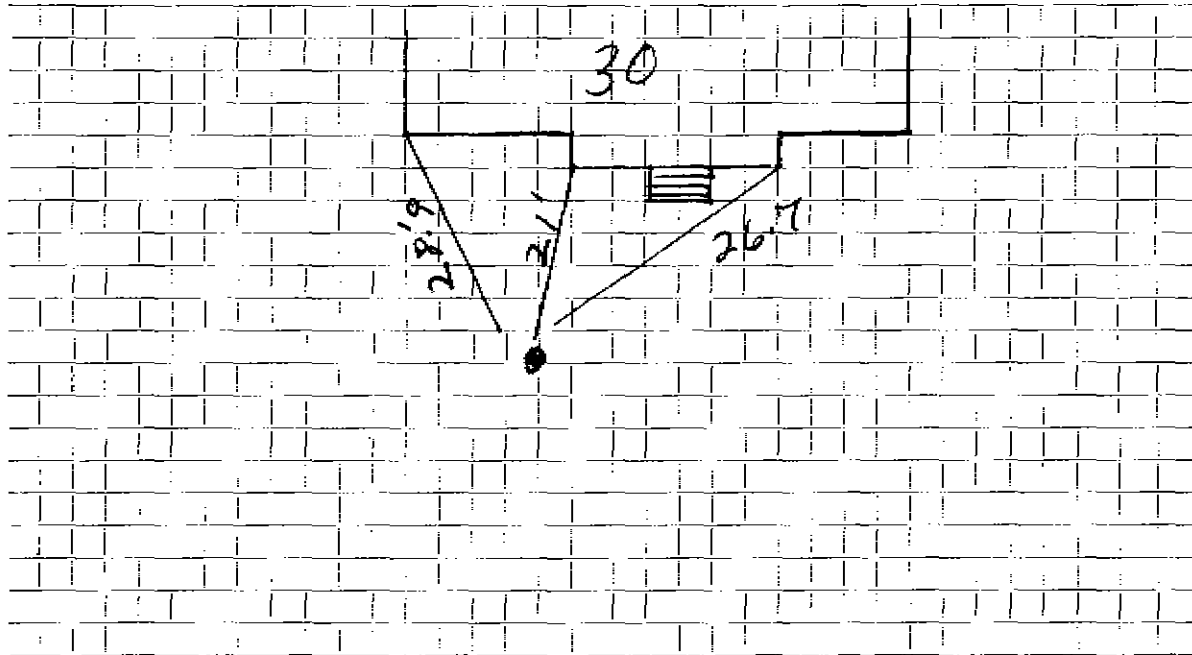

Connection made in ..... Street.      Work completed .....

Remarks: .....

.....  
.....