


DATE _____

TOWN OF LEXINGTON — BOARD OF PUBLIC WORKS

WATER DIVISION

Sketch of Service Here

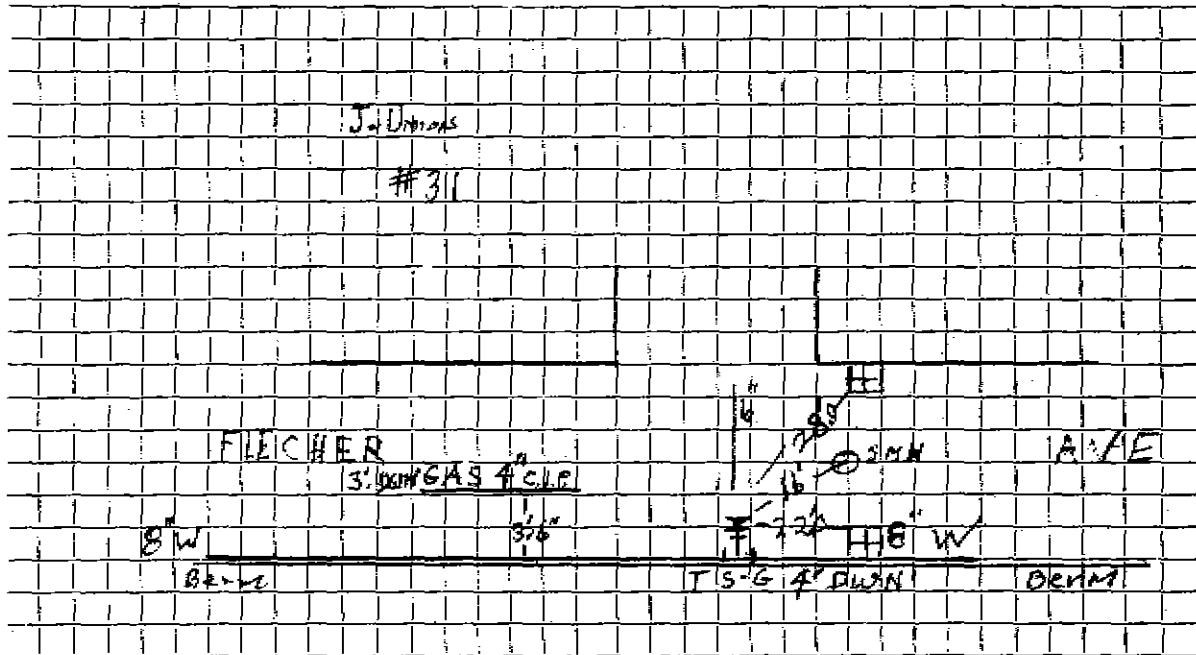

Connection made in Street. Work completed 10/20/05 EJR

Remarks: WATER MAIN cannot line up IN Good shape lined 1986

... WATER MAIN Under berm

Name .

Service No. 885

Address JEFFERSON UNION

Location 31 Fletcher Ave.

Kind of Pipe

Size

Size of Main

Repair—Renewal—New Service

Location

Date	Material	Amount	Total	Date	Amount
	6" SPRINKLER				
Domestic	2" TAP INSIDE BULD				
	Labor				

DATE _____

TOWN OF LEXINGTON—BOARD OF PUBLIC WORKS

WATER DIVISION

The undersigned applies for a supply of water at No. _____ St. and hereby agrees to comply with the rules and regulations as now, or at any future time, established by the Board of Selectmen.


Am't. of Estimate \$ _____

Owner Jefferson Union

Am't. Paid \$ _____

Address 31 Fletcher Ave.

Builder _____

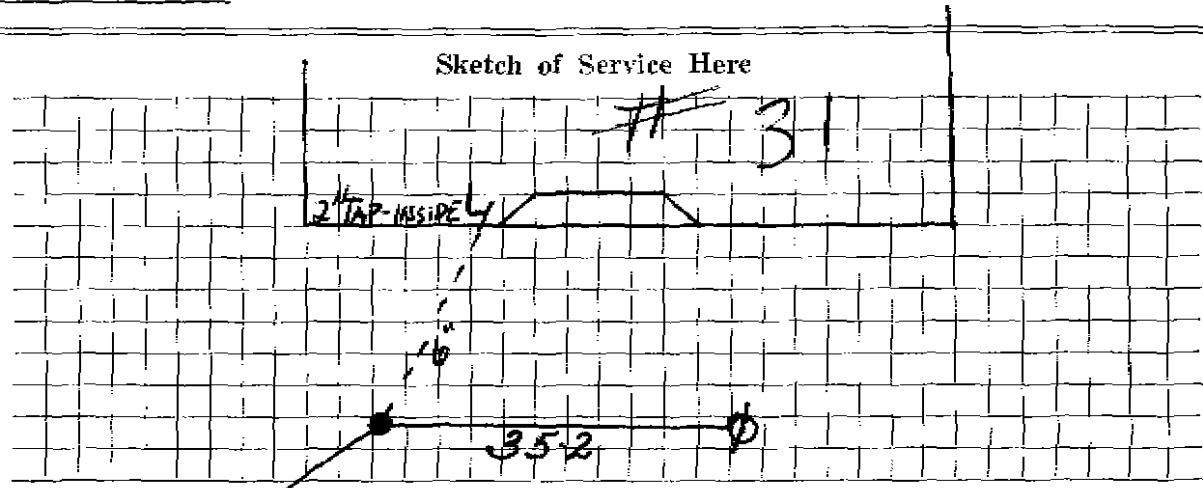

Connection made in _____ Street.

Work completed _____ 19

Remarks:

