

Name Robert Fuller
 Address 36 Fletcher Avenue
 Lexington, Mass.

Service No. 198

Location 36 Fletcher Avenue

Kind of Pipe

Size

Size of Main

~~Repair—Renewal—New Service~~

Com. 9-26-49

Location

Date

Material

Amount

Total

Date

Amount

Sept. 2, '49	Labor	1 25	1 25
	10% Overhead		13
	34' - 3/4" Copper Tubing @ .24		8 16
	1 - 3/4" C x 1/2" I.W.H. S&W		3 29
	Trucking 1 hr. @ .75		75
			<hr/> 13 58

<i>Aug 29 1949</i>	<i>Repaired</i>	15 00
	No Charge	<hr/> 13 58
Sept. 2, '49	Labor	5 02
	11' - 3/4" Copper Tubing @ .24	2 64
	1 - 3/4" C Corp-cock	3 15
	1 - 3/4" C x 3/4" C Curb-cock	3 85
	1 - Box & Rod	3 75
	1 - 1/2" Offset Tail Piece	37
	1 - 1/2" Straight Tail Piece	37
	Patching 7 x 3	7 00
	Littlefield Shovel 2 1/2 hrs.	17 50
	Trucking 1 hr. @ .75	75
		<hr/> 44 40

Labor

DATE _____

TOWN OF LEXINGTON - BOARD OF PUBLIC WORKS

WATER DIVISION

The undersigned applies for a supply of water at No..... St. and hereby agrees to comply with the rules and regulations as now, or at any future time, established by the Board of Selectmen.

Am't of Estimate \$.....


Owner

Am't Paid \$.....

Address

Builder

Sketch of Service Here

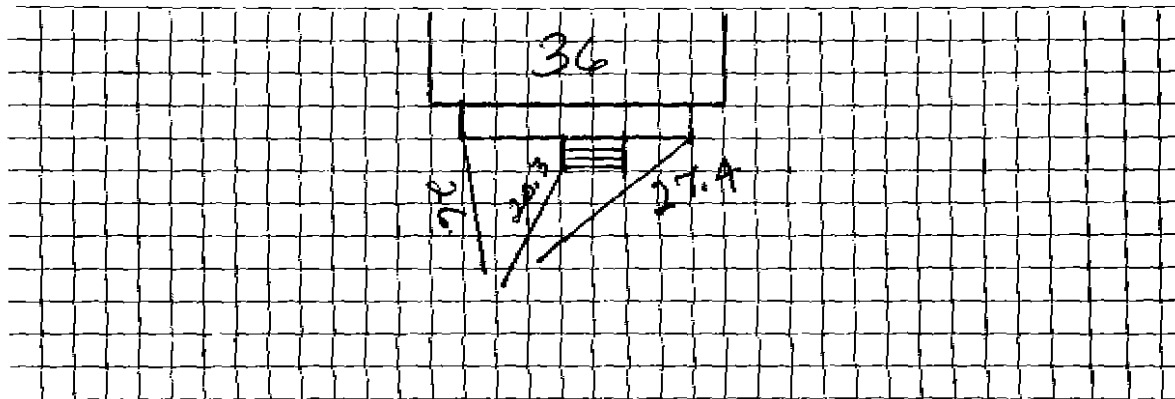

Connection made in Street.

Work completed19

Remarks: