

WATER SERVICE RECORD

Service No.

Name Kathleen White

Address 38 FLETCHER AVE.

Location

~~Repair-Renewal~~ New Service

ALEX #0036


Date	Material	Amount	Total	Date	Amount
3/29/90	25 LF 3/4" COPPER 3/4" COUG w/BOX				

DATE \_\_\_\_\_

TOWN OF LEXINGTON — BOARD OF PUBLIC WORKS

**WATER DIVISION**

Sketch of Service Here

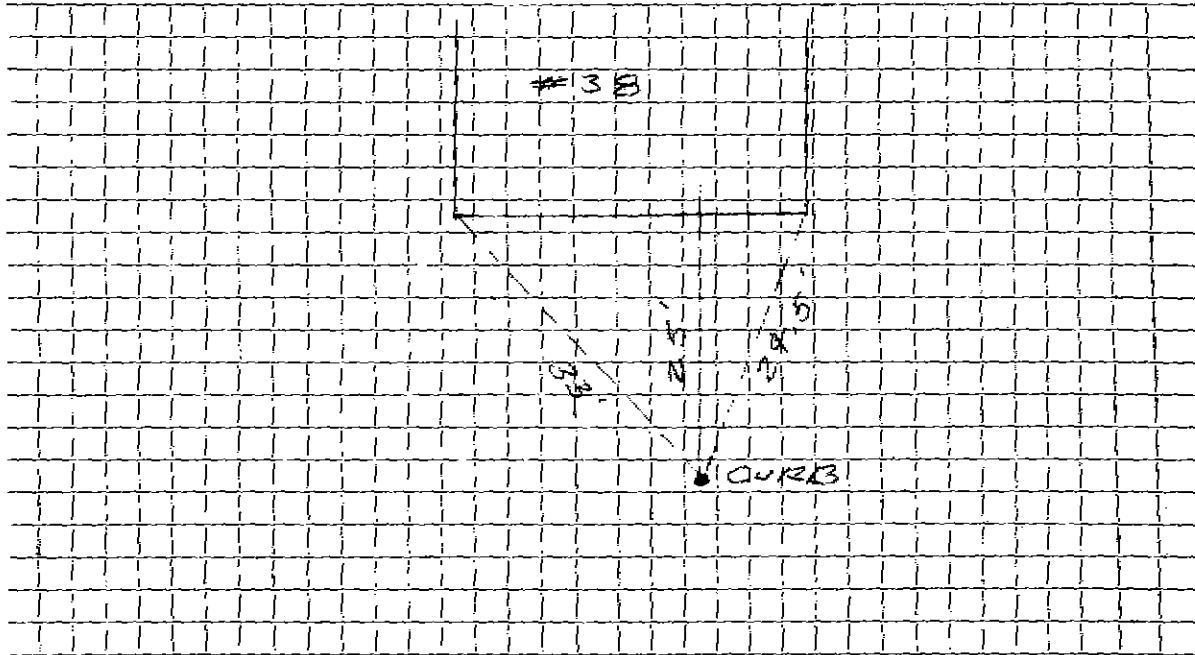

Connection made in FLETCHER AVE. Street.

Work completed 3/29/90

Remarks: .....  
.....  
.....