

WATER SERVICE RECORD

Name Park Department

Service No.

Address 4 Fletcher Avenue

Location

~~Water Service~~ New Service

Date	Material	Amount	Total	Date	Amount
6-12-65	Labor	127.58			
	10% O.H.	12.76	140.34		
10'	1" Copper tubing @.56		5.60		
1	1" x 1" W.H.Stop & Waste		9.69		
3	1" Brass Nipples @.65		1.95	17'	1" Copper tubing @.56
2	1" C x 1" Iron 2 part union @2.80		5.60	1	1" C Corp Cock
6	x 3 Patch		6.00	1	1" C Curb Cock
1	1" Tee		2.20	1	Box & Rod
1	manhole frame & cover		35.00	1	hr. Town Shovel @6.50
1	set blocks 5'		31.32	1	hr. Trucking @3.00
1	bag cement		1.50	1	1" Straight tailpiece
1	hr. Town Shovel @6.50		6.50	1	1" Offset tailpiece
1	hr. Trucking @3.00		3.00		
			248.70		

CURB TO MAIN


47.59

DATE _____

TOWN OF LEXINGTON — BOARD OF PUBLIC WORKS

WATER DIVISION

Sketch of Service Here

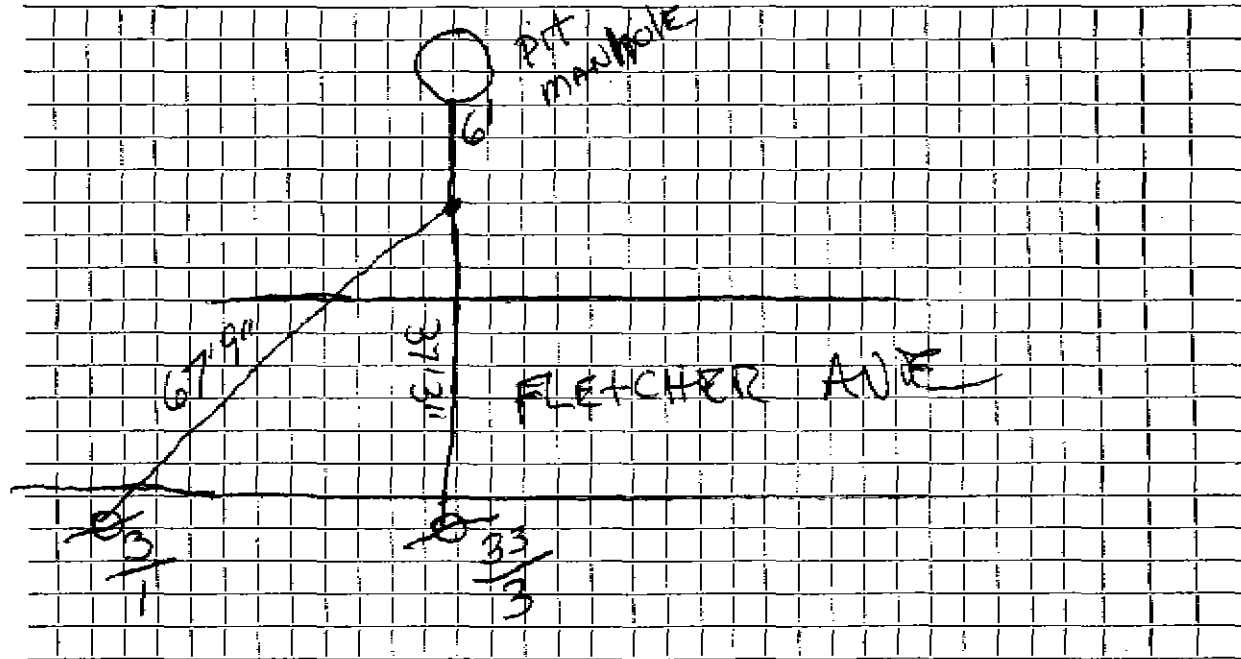

Connection made in Street. Work completed

Remarks:

.....

.....