

WATER SERVICE RECORD

#5893

Name Alfred Batstone

Service No. 28

Address 40 Fletcher Avenue

Location

~~Repair~~—Renewal—~~New Service~~ W.O. #6861

NOV 18 1968


Date	Material	Amount	Total	Date	Amount
6/18/68	Labor	11 24			
	10 % O.H.	1 12	12 36	6-25-68	Deposit
	36' 3/4" Copper tubing @ .79		28 44	11-18-68	Retard
1	3/4" C x 1/2 WH. Stop & Waste		11 13		
1	Hr. Trucking		3 00	6/18/68	<u>CURB TO MAIN</u>
1	Hr. Shovel		6 50		Labor
			61 43		3' 3/4" copper tubing @.79
					1 3/4" Curb Cock
					1 3/4" Adaptor
					500 Lbs cold tank patch
					1 Hr. Town Shovel
					1 Hr. Trucking
					64 45

DATE _____

TOWN OF LEXINGTON — BOARD OF PUBLIC WORKS

WATER DIVISION

Sketch of Service Here

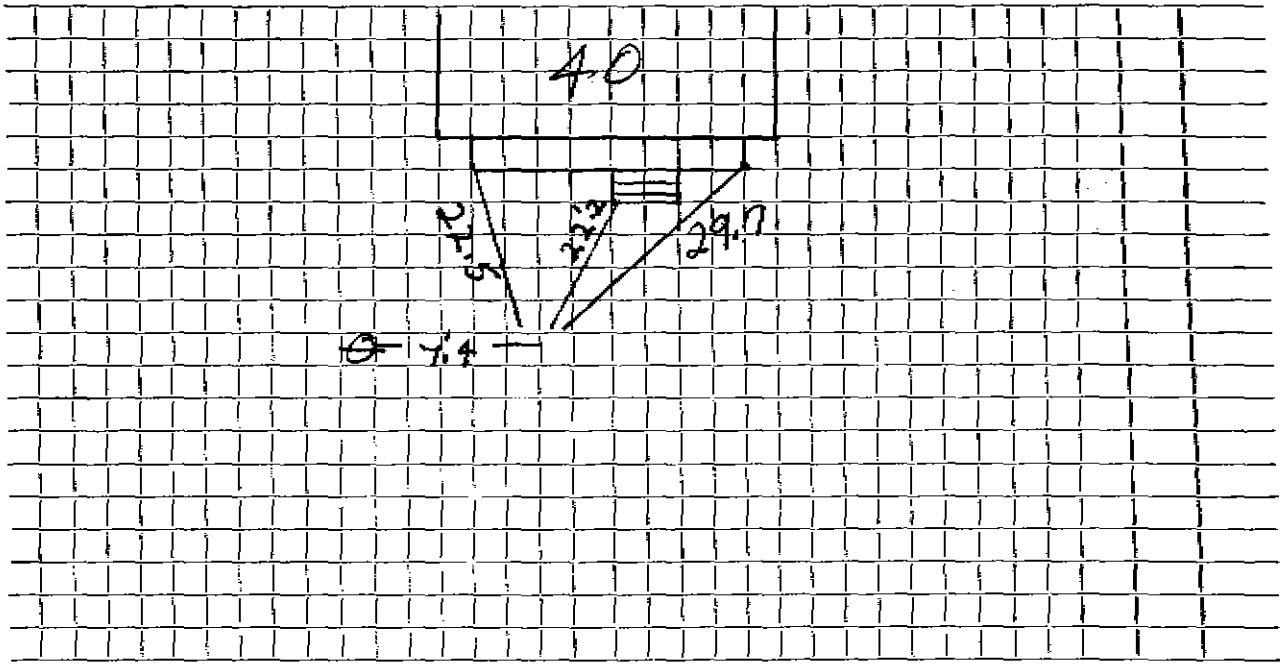

Connection made in Street. Work completed

Remarks:
.....
.....