

WATER SERVICE RECORD

Name *C. W. Morgan Co. Inc.*

Service No.

Address *43 Fletcher Avenue*

Location *Lot B*

~~Repair, Renewal~~ *New Service* *Surianello #4501*
 XXXXXXXXXXXXXXXX


Date	Material	Amount	Total	Date	Amount
<i>11/17/83</i>	<i>47'</i>	<i>1" Copper tubing</i>			
					<i>OUTSIDE</i>
				<i>11/17/83</i>	<i>27'</i>
					<i>1" Copper tubing</i>
					<i>1" Corp</i>
					<i>1" Curb</i>
					<i>Box & Rod</i>

DATE _____

TOWN OF LEXINGTON — BOARD OF PUBLIC WORKS

WATER DIVISION

Sketch of Service Here

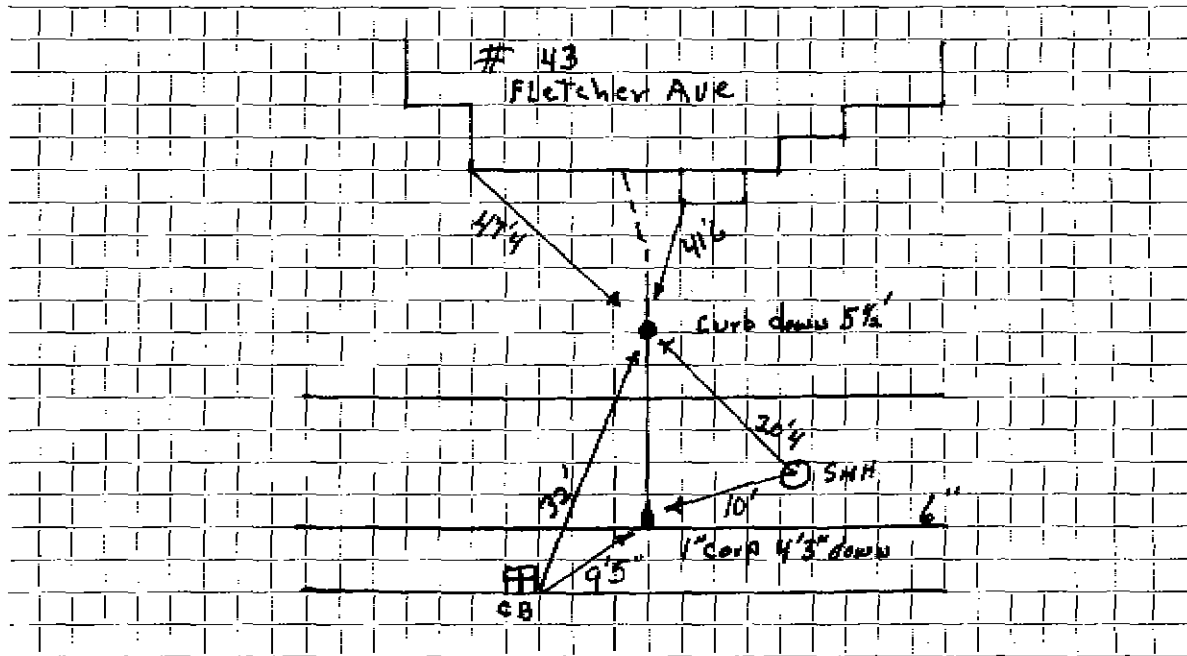

Connection made in Street. Work completed

Remarks: *Copper goes over drain - Sewer under*