

#3483

WATER SERVICE RECORD

Name Edgar Shepard

Service No. 12

Address 46 Fletcher Avenue

1798

Location

~~Repair~~ ~~Renewal~~ ~~New Service~~ W.O. # 9591

OCT 4 1971


Date	Material	Amount	Total	Date	Amount
5/28/71	Labor	63 76		5-24-71	Deposit 225 00
	10% O.H.	6 38	70 14	6-4-71	Refund 159 99
33'	3/4" Copper pipe .79		26 07		115 91
1	3/4" Wheel Valve		9 30	8/26/59	
1	Hr. Trucking		3 00	12'	3/4 COPPER
1	Hr. Shovel		6 50	1	3/4 ADAPTER
			115 01	1	3/4 CURB Box + Rod

DATE _____

TOWN OF LEXINGTON — BOARD OF PUBLIC WORKS

WATER DIVISION

Sketch of Service Here

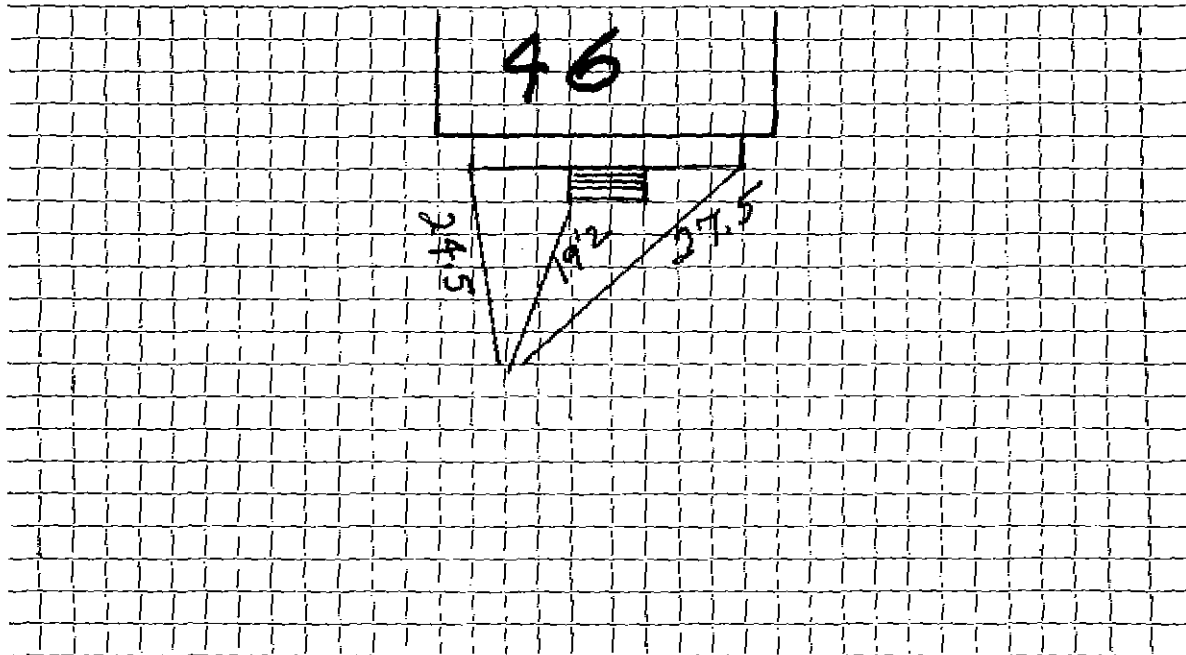

Connection made in Street. Work completed

Remarks:
.....
.....