

Name James Collientro

Service No.

3283

Address 5 Fletcher Avenue

Lexington, Mass.

Location 5 Fletcher Avenue

Kind of Pipe

Size

Size of Main

~~Repair-Renewal~~—New Service

Location

Date	Material	Amount	Total	Date	Amount
June 14, '47	Labor	1 05	1 05	June 13, '47	15 00
	10% Overhead		11	Sept 23, '47	2
	29' - 3/4" Copper Tubing @.27	7 83	7 83		12 89
	1 - 3/4" C x 3/4" I.W.H. S & W	3 15	3 15	June 14, '47	15 05
	Trucking 1 hr. @.75	75	75	27' - 3/4" Copper Tubing @.27	7 29
			12 89	1 - 3/4" C Corp-cock	3 00
				1 - 3/4" C x 3/4" C Curb-cock	3 68
				1 - Box & Rod	4 26
				1 - 1/2" Offset Tail Piece	30
				1 - 1/2" Straight Tail Piece	30
				Trucking 1 hr. @.75	75
					34 33
	Labor				

Hadley Press, Inc., Lexington

DATE _____

TOWN OF LEXINGTON—BOARD OF PUBLIC WORKS

WATER DIVISION

The undersigned applies for a supply of water at No. _____ St. and hereby agrees to comply with the rules and regulations as now, or at any future time, established by the Board of Selectmen.

Am't. of Estimate \$ _____


Owner _____

Am't. Paid \$ _____

Address _____

Builder _____

Sketch of Service Here

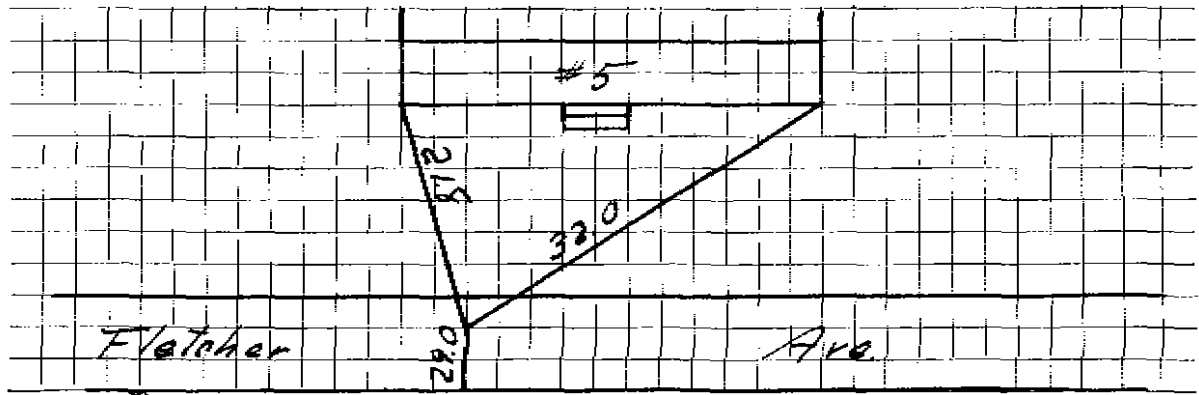

Connection made in _____ Street.

Work completed _____ 19

Remarks: