


DATE 11-29-'90

TOWN OF LEXINGTON — BOARD OF PUBLIC WORKS
WATER DIVISION

Sketch of Service Here

6 FLETCHER AVE.

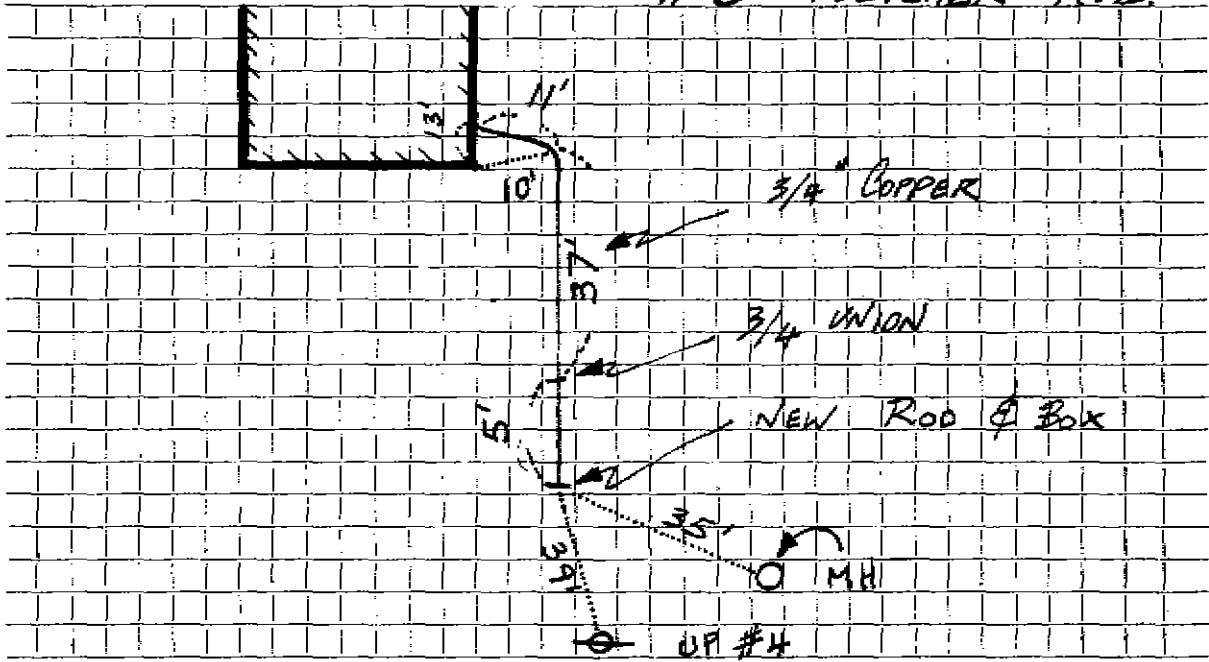

Connection made in ... FLETCHER AVE. ... ~~STREET~~ Work completed

Remarks: INSPECTED 11-29-'90 BY P. BARROWS INSTALLED BY REDMOND