

Name

1349

Service No. 873

Address 7 Fletcher Ave.

Location 7 Fletcher Ave.

Kind of Pipe

Size

Size of Main

Repair—Renewal—New Service

Location

Date	Material	Amount	Total	Date		Amount
					"Outside" Renewal	W.O. #3488
				6-27-75	Labor	106.80
				7-31-75	"	19.23
						\$106.03
					30' 3/4" Coppr Tubing	
					1 3/4" Curb Stop	
					1 1" Lead lined coupling	
					1 1" x 6" CL Nipple	
					1 1" Dresser Coupling	
					1 3/4" Corporation Adapter	
					1 Ton Cold Patch	
					1 Ton Hot Top	
					3 Hrs. Trucking	
					2 Hrs. Pickup	
					3 Hrs. Backhoe	
					1 Hr. Roller	
	Labor					

DATE \_\_\_\_\_

# TOWN OF LEXINGTON—BOARD OF PUBLIC WORKS WATER DIVISION

The undersigned applies for a supply of water at No. \_\_\_\_\_ St. and hereby agrees to comply with the rules and regulations as now, or at any future time, established by the Board of Selectmen.

Am't. of Estimate \$ \_\_\_\_\_

Owner

*T. Fitzgerald*


Am't. Paid \$ \_\_\_\_\_

Address

*7. Fletcher Ave*

Builder \_\_\_\_\_

Sketch of Service Here

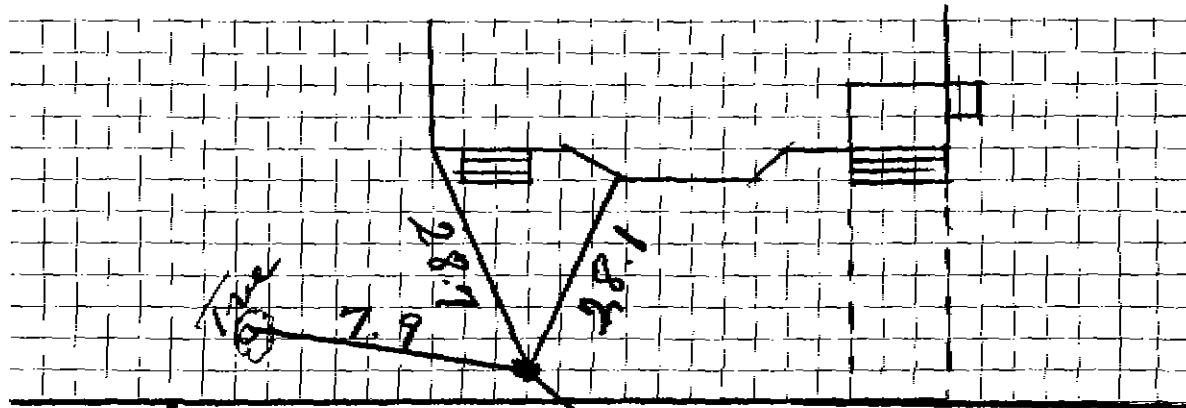

Connection made in

*Fletcher*

Street.

*ave*

Work completed

19

Remarks:

*Hyd*