

WATER SERVICE RECORD

# 358  
# 5388

Name Sheldon/Cataldo

Service No. 390 N.d.

Address 8 FLETCHER AVE

PERMIT # 1523

Location SHERMAN ST SIDE


Repair  ~~Renewal~~  New Service

Date	Material	Amount	Total	Date		Amount
5-2000	INSIDE					
	38' 1" COPPER					
	1-3/4X1" ADAPT.					

DATE 10-1-01

TOWN OF LEXINGTON — BOARD OF PUBLIC WORKS  
**WATER DIVISION**

Sketch of Service Here

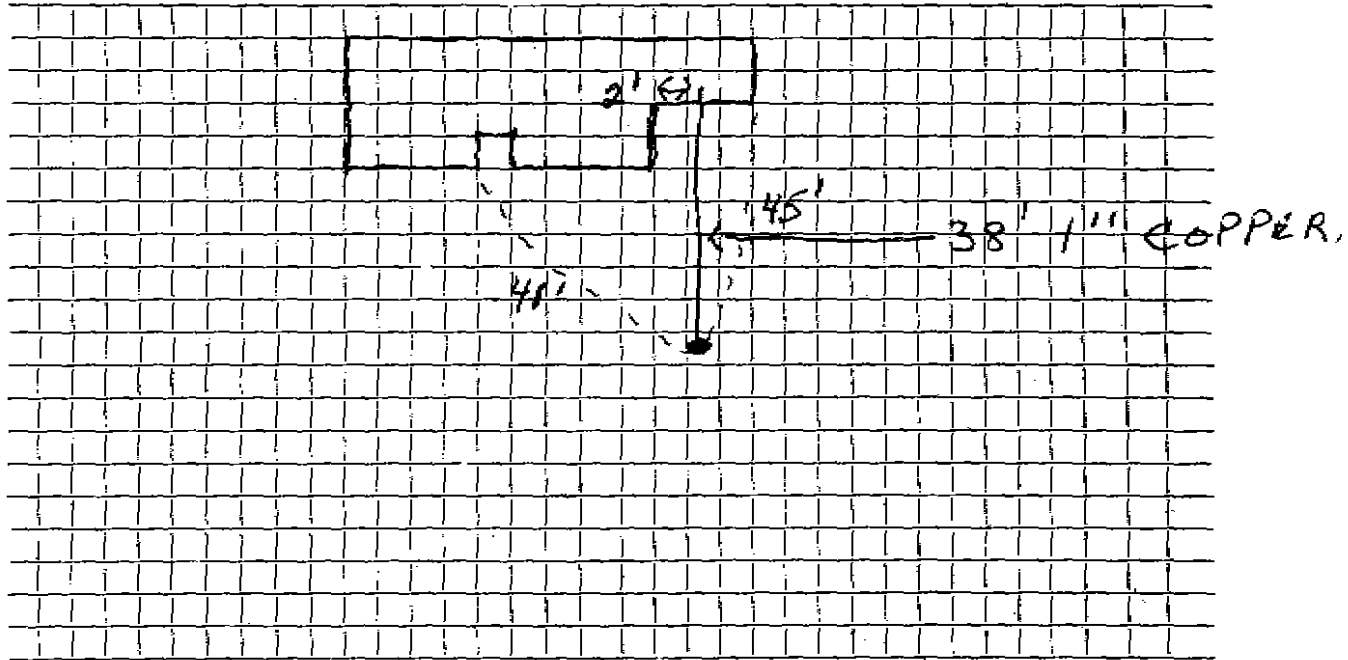

Connection made in ... SHERMAN ..... Street. Work completed .....

Remarks: INSTALLED BY J. M. McLAUGHLIN .....

.....  
.....