

WATER SERVICE RECORD

Service No. 182

#5997

Name Ralph J. Prissore

Address 9 Fletcher Avenue

Location

Revised Manual - New Service

*Rev. 8-15-55*

Date	Material	Amount	Total	Date	Amount
6/22/55	Labor	1 85			
	10% overhead	19	2 04	6-14-55	
	351 - 3/4" copper tubing @ .3693	12 82		8-15-55	
	1 - 2/4" O.K. I.W.H. stop_waste	4 00			
	1 hr. trucking	75		6/22/55	Labor
	1 - 2/4" copper tubing @ .3693	19 71			
	1 - 2/4" O.K. comp-cock	4 32			
	1 - 3/4" O x 3/4" O. comp-cock	4 67			
	1 box galv. zinc	3 80			
	1 - 3/4" straight tail piece	50			
	1 - 3/4" offset tail piece	50			
	1 hr. trucking	75			
		<u>26 47</u>			


*Deposited*  
*5 29*  
*19 71*  
 NON CHARGE

DATE \_\_\_\_\_

TOWN OF LEXINGTON — BOARD OF PUBLIC WORKS

**WATER DIVISION**

Sketch of Service Here

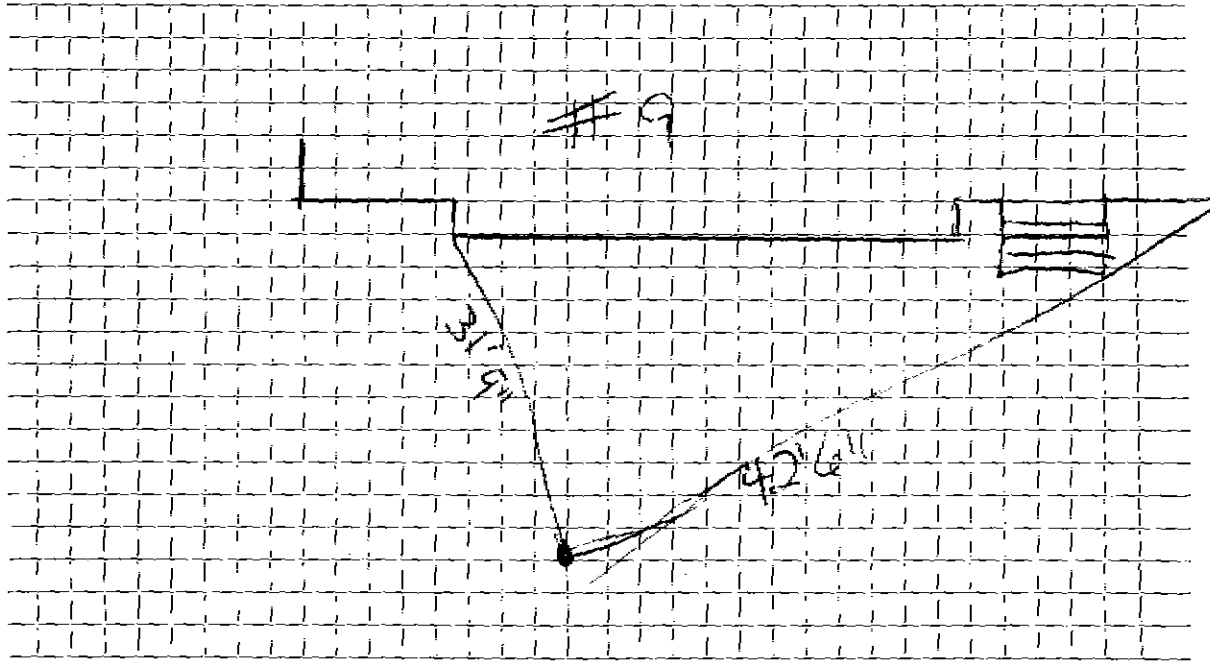

Connection made in ..... Street. Work completed .....

Remarks: .....  
.....  
.....