




DATE OCTOBER 1984

TOWN OF LEXINGTON — BOARD OF PUBLIC WORKS

WATER DIVISION

Sketch of Service Here

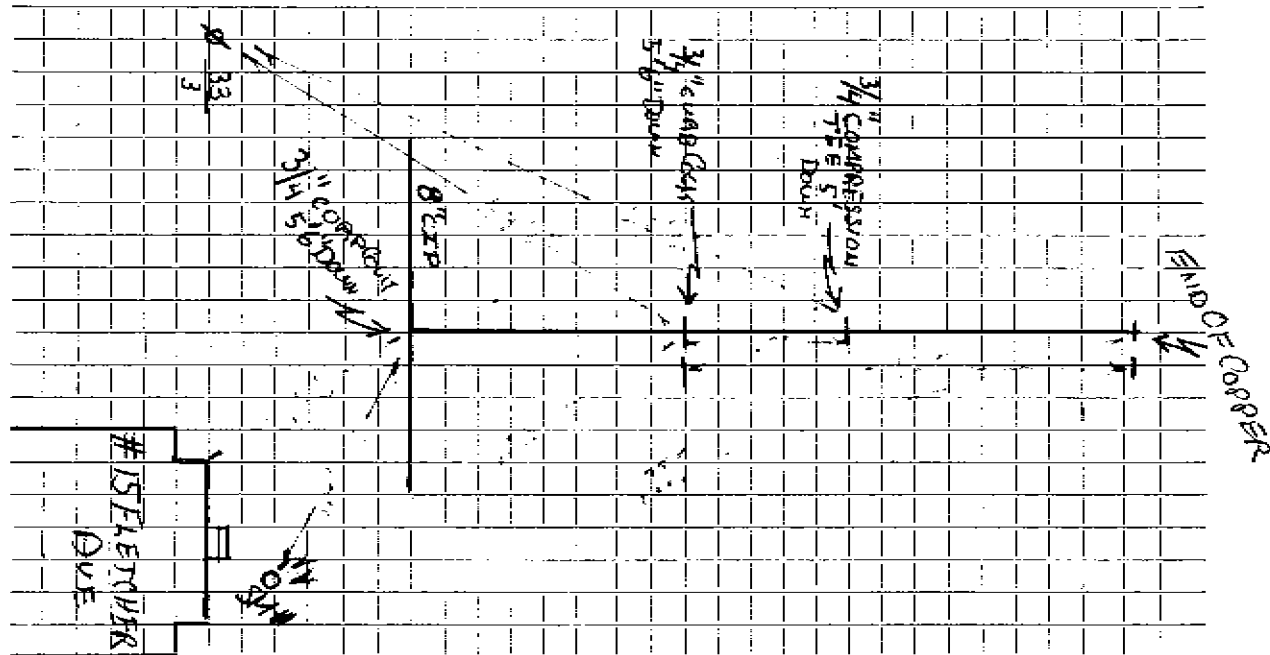

Connection made in FLETCHER AVE Street. Work completed OCT 18, 1984.

Remarks: SERVICE FOR TWO CONSTRUCTION TRAILERS