




DATE 1/21/2020

TOWN OF LEXINGTON — BOARD OF PUBLIC WORKS

WATER DIVISION

Sketch of Service Here

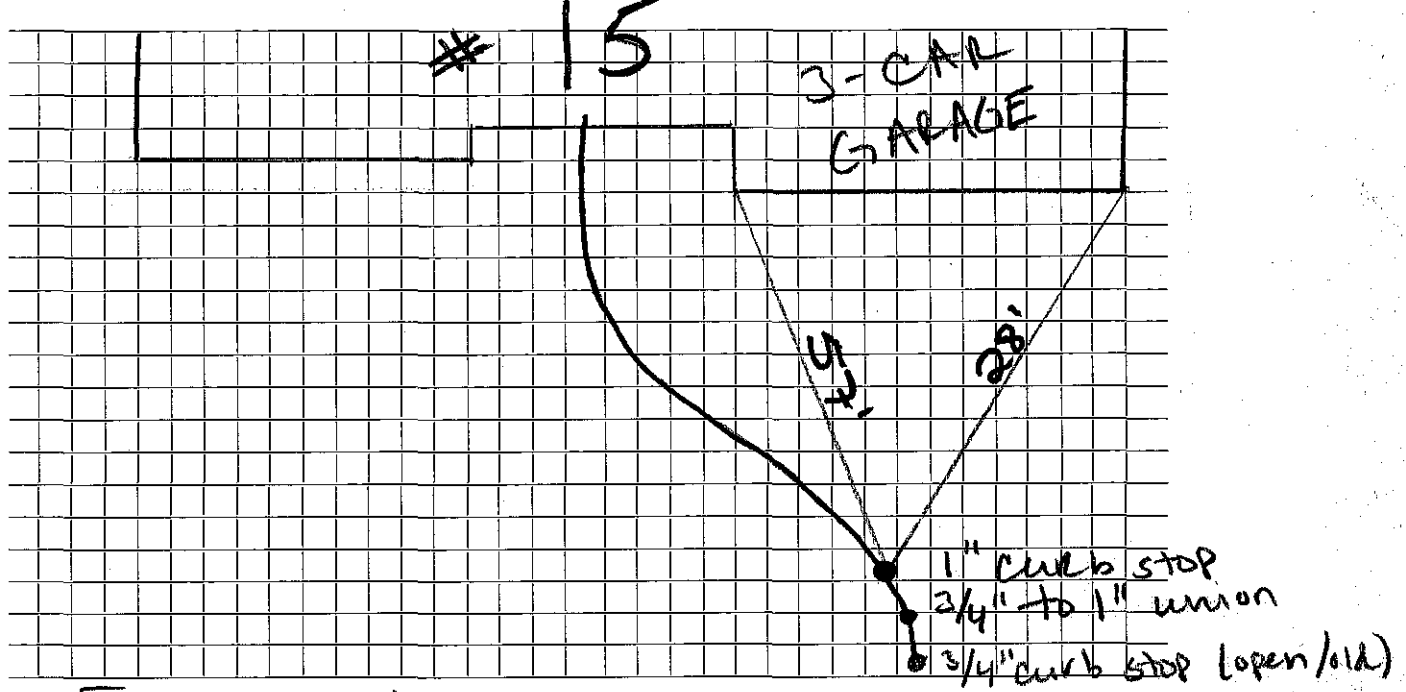

Connection made in Flintlock Rd Street.

Work completed .....

Remarks: .....

.....

.....