

WATER SERVICE RECORD

Name Speedwagon Partners

Service No. _____

Address 25 Fintrock Rd

Location _____

Repair ~~Renewal~~ New Service


Date	Material	Amount	Total	Date		Amount
1/20/21	1" type k copper					
	1" curb stop open right camb. brass					
	1" to 3/4" union buffalo box					

DATE 1/20/2021

TOWN OF LEXINGTON — BOARD OF PUBLIC WORKS

WATER DIVISION

Sketch of Service Here

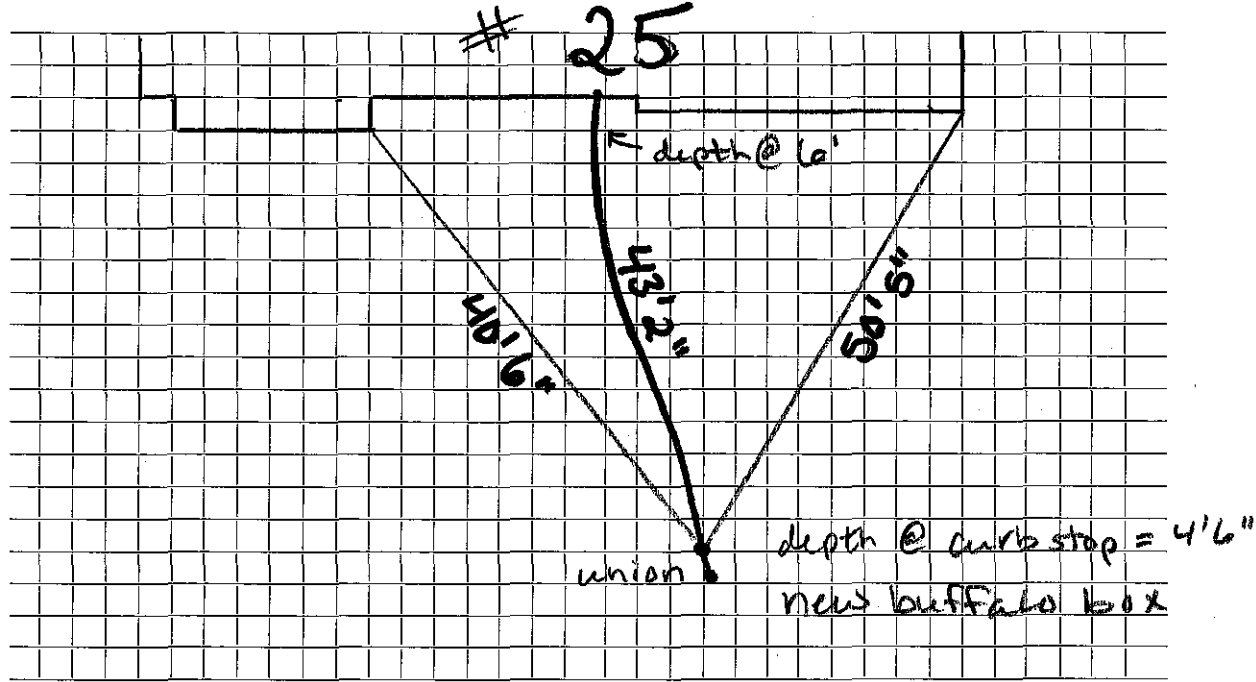

Connection made in Fintrock Rd Street: Work completed

Remarks:.....