

WATER SERVICE RECORD

Name Universal Builders, Inc.

Service No. 324

Address 11 Flintlock Road

Location

~~Repair~~ ~~Renewal~~ — New Service


Com. 11-23-53

Date	Material	Amount	Total	Date	Amount
10/28/53	Labor	1 75		10-14-53	Deposited 35 00
	10% overhead	18	1 93	11-23-53	Refunded (13 80
	40' - 3/4" copper tubing@ .3629	14 52			NON CHARGE 21 20
	1 -3/4" c x 1/2 I.W.F.s top & waste	4 00		10/28/53	Labor 4 75
	1 hr. trucking		75		30' - 3/4" copper tubing@.3629 10 89
			21 20		1 -3/4"C corp-cock 4 33
	TRENCH DUG BY OWNER:				1 -3/4"C x 3/4"C. curb-cock 4 67
					1 box and rod 3 90
					1 -1/2 offset tail pc. 50
					1 -1/2 straight tail pc. 50
					1 hr. trucking 75
					30 29

DATE _____

TOWN OF LEXINGTON — BOARD OF PUBLIC WORKS
WATER DIVISION

Sketch of Service Here

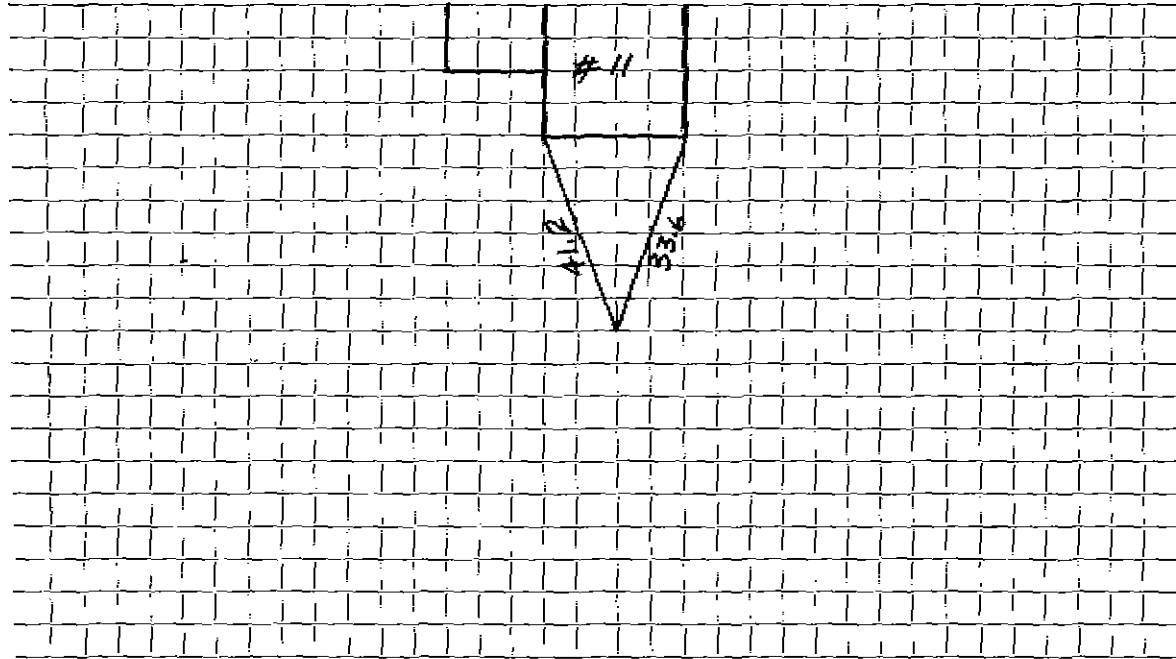

Connection made in Street. Work completed

Remarks:

.....
.....