

WATER SERVICE RECORD

Name Universal Builders, Inc.

Service No. 292

Address 12 Flintlock Road

Location

~~Repair - Renewal~~ - New Service


Com. 11-23-53

Date	Material	Amount	Total	Date	Amount
10/22/53	Labor	1 75		9-16-53	Deposited 25 -
	10% overhead	18	1 93	11-23-53	Refunded (10 17)
	50' - 3/4" copper tubing@.3629	18 15			<u>NON CHARGE</u> 24 83
	1 - 3/4" C x 1/2" I.W.H. stop & waste	4 00		10/22/53	Labor 3 70
	1 hr. trucking		75		6' - 3/4" copper tubing@.3629 2 18
			24 83		1 - 3/4" C. corp-cock 4 33
	TRENCH DUG BY OWNER:				1 - 3/4" C x 3/4" C. curb-cock 4 67
					1 box end rod 3 90
					1 - 1/2" offset tail pc. 50
					1 - 1/2" straight tail pc. 50
					1 hr. trucking 75
					<u>20 53</u>

DATE _____

TOWN OF LEXINGTON — BOARD OF PUBLIC WORKS
WATER DIVISION

Sketch of Service Here

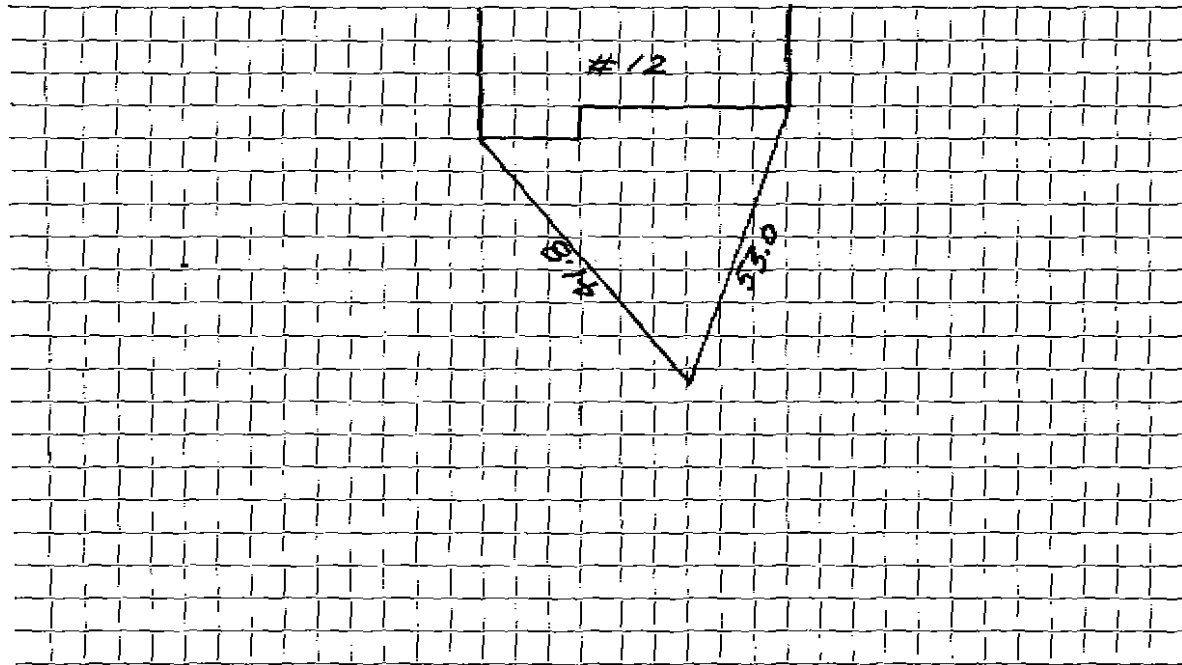

Connection made in Street. Work completed

Remarks:
.....
.....