

WATER SERVICE RECORD

Name Universal Builders, Inc.

Service No. 293

Address 14 Flintlock Road

Location

~~Repair~~ ~~Replacement~~ New Service


Com. 11-23-53

Date	Material	Amount	Total	Date	Amount
10/22/53	Labor	1 75		9-16-53	Deposited 35 00
	10% overhead	18	1 93	11-23-53	Refunded (7 27)
	58' -3/4" copper tubing@.3629	21 05			<u>NON CHARGE</u> 27 23
	1 -3/4" C x 1/2 I.W.H. stop & waste	4 00		10/22/53	Labor 3 70
	1 hr. trucking		75		10' + 3/4" copper tubing@.3629 3 63
			27 73		1 -3/4" C. corp-cock 4 33
					1 -3/4" C x 3/4" C. curb-cock 4 67
	TRINCH DUG BY OWNER:				1 box and rod 3 90
					1 -1/2 offset tail pc. 50
					1 -1/2 straight tail pc. 50
					1 hr. trucking 75
					<u>21 98</u>

DATE _____

TOWN OF LEXINGTON — BOARD OF PUBLIC WORKS
WATER DIVISION

Sketch of Service Here

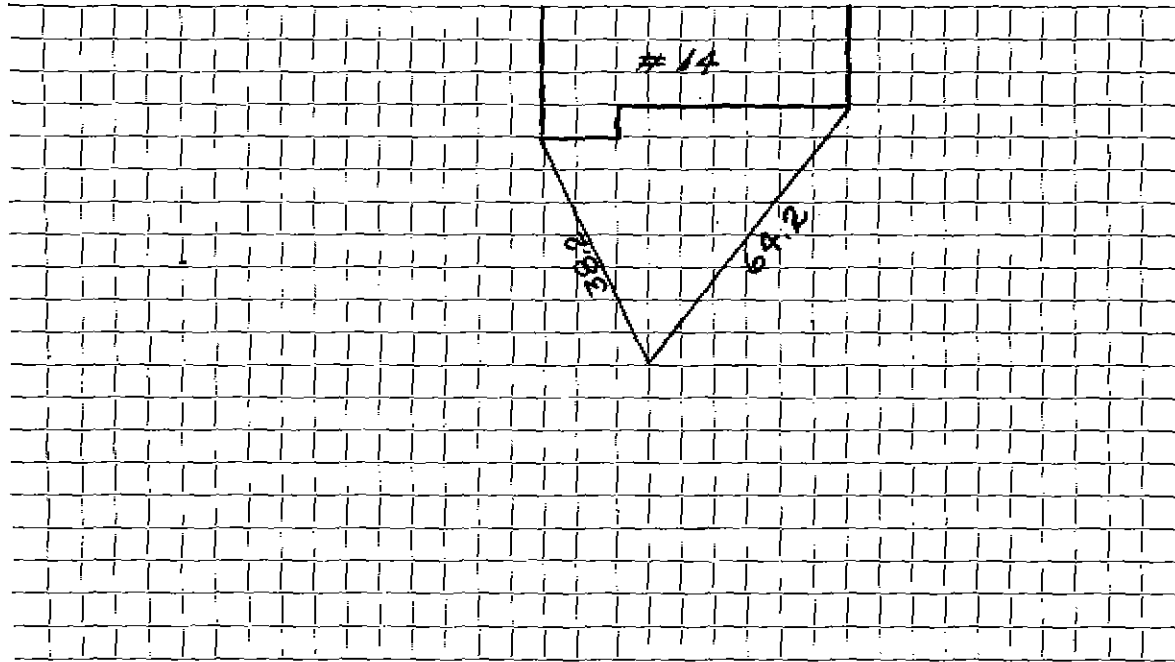

Connection made in Street. Work completed

Remarks:
.....
.....