

WATER SERVICE RECORD

Name Universal Builders, Inc.

Service No. 114

Address 18 Flintlock Road

7569

Location

~~Repair~~ ~~XXXXXX~~ ~~XXXX~~ - New Service

CO. 7-19-54


| Date | Material | Amount | Total | Date | Amount |
|--------|---------------------------------------|--------|-------|--------------------------------|-------------------|
| 6/4/54 | Labor | 1 73 | | 5-24-54 Deposited | 30 00 |
| | 10% overhead | 17 | 1 90 | 7-20-54 Refunded * | (9 35) |
| | 40' - 3/4" copper tubing @ .35 | | 14 00 | | <u>NON CHARGE</u> |
| | 1 - 3/4" C x 1/8" I.W.H. Stop & waste | | 4 00 | 6/4/54 Labor | 1 72 |
| | 1 hr. trucking | | 75 | 10' - 3/4" copper tubing @ .35 | 3 50 |
| | | | 20 65 | 1 - 3/4" C. corp-cock | 4 33 |
| | TRENCH DUG BY OWNER: | | | 1 - 3/4" C. curb-cock | 4 67 |
| | | | | 1 box and rod | 3 90 |
| | | | | 1 - 1/2" straight tail piece | 50 |
| | | | | 1 - 1/2" offset tail piece | 50 |
| | | | | 1 hr. trucking | 75 |
| | | | | | <u>19.87</u> |

* 9.35 applied to water rates
acct B-96-8

DATE _____

TOWN OF LEXINGTON — BOARD OF PUBLIC WORKS
WATER DIVISION

Sketch of Service Here

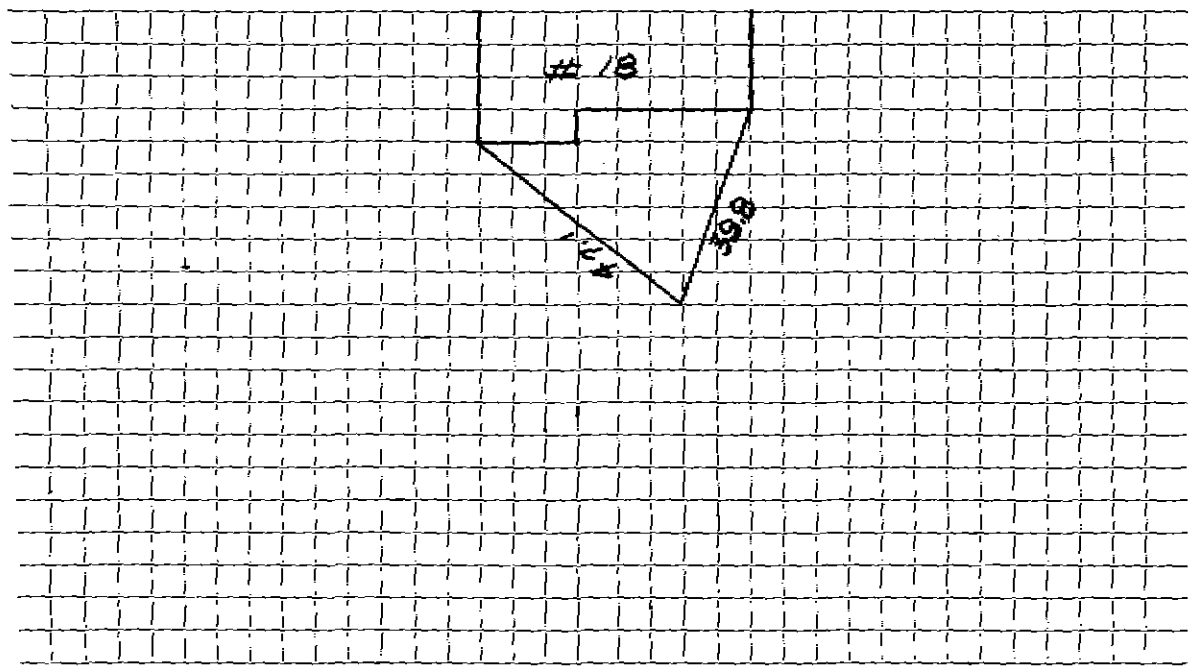

Connection made in Street. Work completed

Remarks:
.....
.....