

WATER SERVICE RECORD

Name Universal Builders, Inc.

Service No. 115

Address 19 Flintlock Road

Location

~~Repair~~ ~~Work~~ - New Service

CO. 7-19-54

Date	Material	Amount	Total	Date	Amount
6/8/54	Labor	1 85		5-24-54 Deposited	30 00
	10% overhead	19	2 04	7-20-54 Refunded *	(2 21
	60' - 3/4" copper tubing@.35		21 00		<u>NON CHARGE</u>
	1 - 3/4"C x 3/8 I.W.P. stop & waste	4 00		6/8/54 Labor	1 85
	1 hr. trucking		75	36' - 3/4" copper tubing@.35	12 60
			27 79	1 - 3/4"C. corp-cock	4 33
	TRENCH DUG BY OWNER			1 - 3/4"C. curb-cock	4 67
				1 - box end rod	3 90
				1 - 1/2" straight tail piece	50
				1 - 1/2" offset tail piece	50
				1 hr. trucking	75
					<u>29 10</u>


* 2.21 made payable to farm & apply on water rates oct. 8-9-53

DATE _____

TOWN OF LEXINGTON — BOARD OF PUBLIC WORKS

WATER DIVISION

Sketch of Service Here

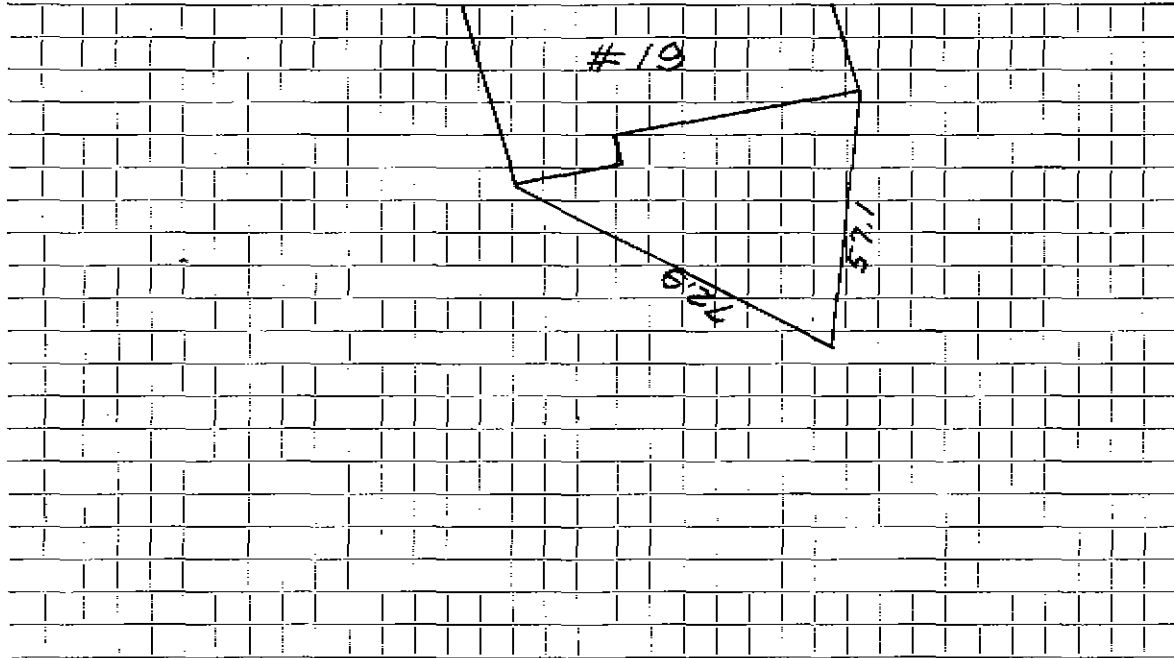

Connection made in Street. Work completed

Remarks:
.....
.....