

WATER SERVICE RECORD

Name Universal Builders, Inc.

Service No. 116

Address 21 Flintlock Road

Location

~~Repair~~ ~~Renewal~~ — New Service

CO. 7-19-54

Date	Material	Amount	Total	Date	Amount
6/21/54	Labor	1 72		5-24-54 Deposited	30 00
	10% overhead	17	1 89	7-20-54 Refunded *	(2 36)
	60' - 3/4" copper tubing@.35		21 00	<u>NON CHARGE</u>	27 64
	1 - 3/4"C x 1/2 I.W.H.stop & waste	4 00		6/21/54 Labor	1 73
	1 hr. trucking		75	22' - 3/4" copper tubing@.35	7 70
			27 64	1 - 3/4"C. corp-cock	4 33
	TRENCH DUG BY OWNER:			1 - 3/4"C. curb-cock	4 67
				1 box and rod	3 90
				1 - 1/2" straight tail pc.	50
				1 - 1/2" offset tail pc.	50
				1 hr. trucking	75
					24 08


* 2.36 applied to water rates acct B96-3

DATE _____

TOWN OF LEXINGTON - BOARD OF PUBLIC WORKS

WATER DIVISION

Sketch of Service Here

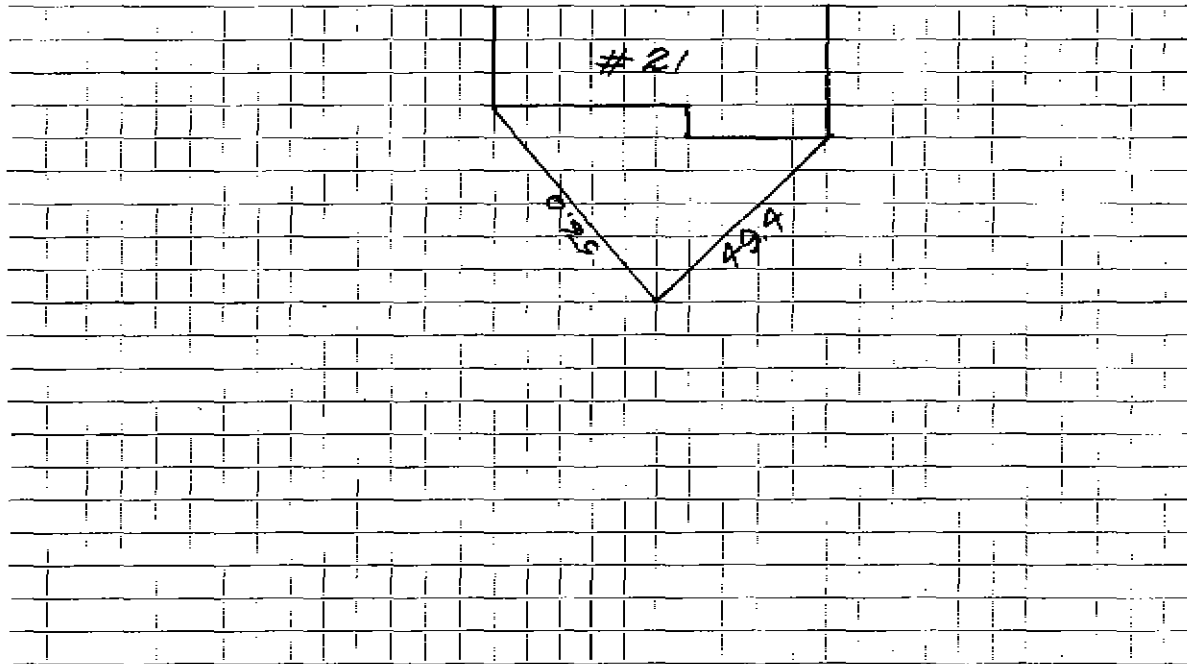

Connection made in Street. Work completed

Remarks:

.....

.....