

WATER SERVICE RECORD

5303

Name Edmund Johnston

Service No. 112

Address 22 Flintlock Road (lot 12A)

Location

~~Repair~~ ~~Renewal~~ New Service

SERVICE IN TO CURB:

Comm 11-17-58

Date	Material	Amount	Total	Date	Amount
6/19/58	Labor	3 54		6-17-58	35 00
	10% overhead	35	3 89	11-17-58	2 32
	60'-3/4" copper tubing @.37		22 20		NON CHARGE
	1-3/4" Cx 1/2 I.W.H. stop & waste	5 84		8/11/54	Labor
	1 hr. trucking @.75		75		3 70
			32 68		10' - 3/4" copper tubing @ .35
					3 50
					1 - 3/4"C. corp-cock
					4 33
					1 - 3/4"C. curb-cock
					4 67
					1 box and rod
					3 90
					1 hr. trucking
					75
					20 85
				6/19/58	1-1/2" straight tail piece
					50
					1-1/2" offset tailpiece
					50
					21 85


DATE _____

TOWN OF LEXINGTON — BOARD OF PUBLIC WORKS

WATER DIVISION

Sketch of Service Here

SERVICE FOR # 22

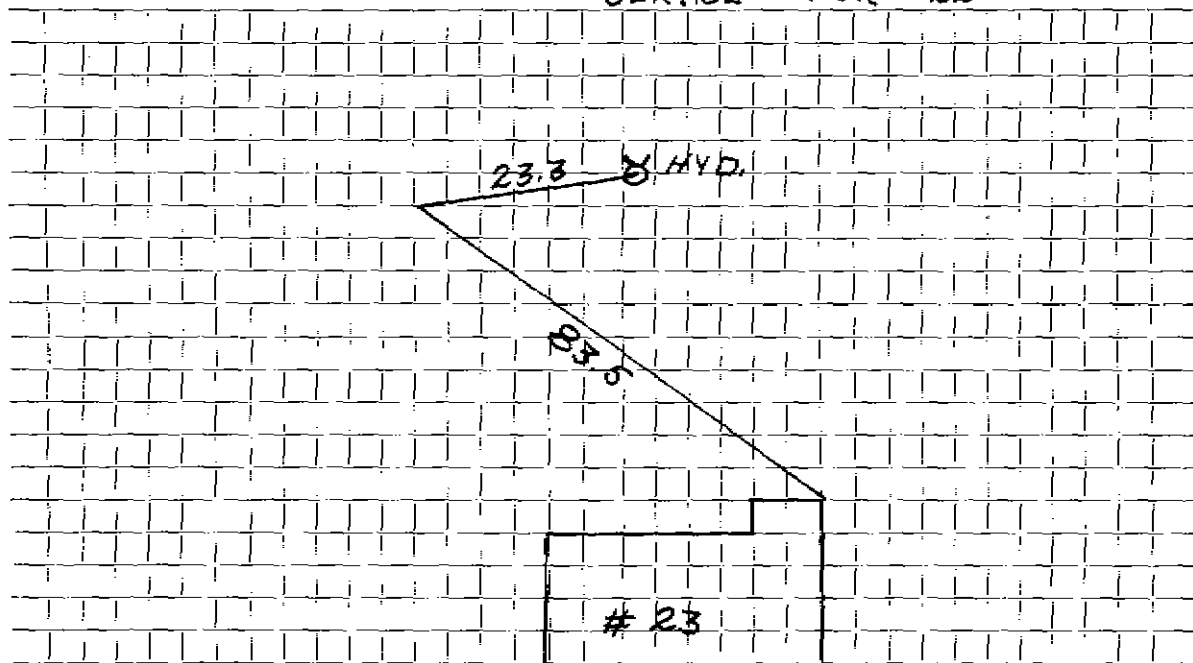

Connection made in Street. Work completed

Remarks:
.....
.....