

WATER SERVICE RECORD

Name

Service No.

Address 23 Flintlock Road (lot 52)

Location

~~Repair/Reconnect~~—New Service SERVICE IN TO CURB:

Date	Material	Amount	Total	Date	Amount
7-16-55					
	125' 3/4" Copper				
	1 3/4" - 3 Part Union				
	1 3/4" C X 1/2" I.W.H. Stop + Waste				
				8/11/54 Labor	3 70
				30' - 3/4" copper tubing @ .35	10 50
				1 - 3/4" C. corp-cock	4 33
				1 - 3/4" C. curb-cock	4 67
				1 - box and rod	3 90
				1 hr. trucking	75
					<u>27 85</u>


NON CHARGE

DATE \_\_\_\_\_

TOWN OF LEXINGTON — BOARD OF PUBLIC WORKS

**WATER DIVISION**

Sketch of Service Here

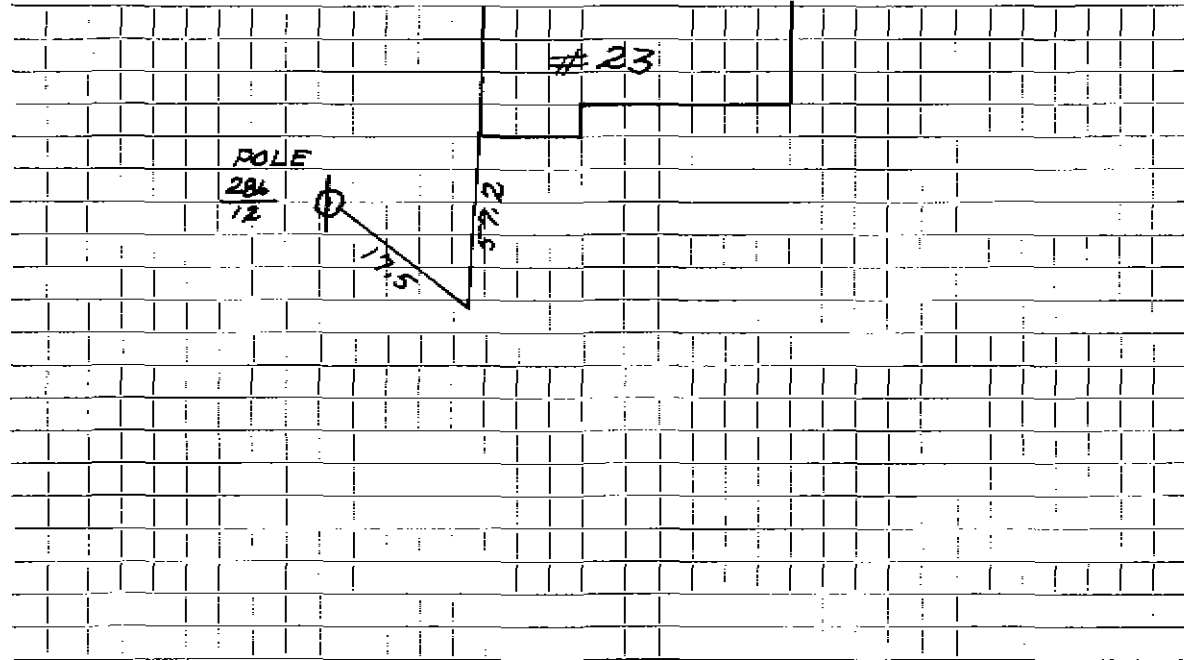

Connection made in ..... Street. Work completed .....

Remarks: .....  
.....  
.....