

WATER SERVICE RECORD

3051  
3052

Name Universal Builders, Inc.

Service No. 117

Address 24 Flintlock Road

Location

~~Repair~~ New Service 001. 7-19-54

Date	Material	Amount	Total	Date	Amount
6/23/54	Labor	1 78		5-21-54 Deposited	3000
	10% overhead	18	1 96	7-20-54 Refunded *	579
	50' - 3/4" copper tubing@ .35	17 50			24 21
	1 - 3/4" C x 1/2" I.W.H. stop & waste	4 00		6/23/54 Labor	1 78
	1 hr. trucking		75	10' - 3/4" copper tubing@ .35	3 50
			24 21	1 - 3/4" C. corp-cock	4 33
	TRENCH DUG BY OWNER:			1 - 3/4" C. curb-cock	4 67
				1 box and rod	3 90
				1 - 1/2" straight tail piece	50
				1 - 1/2" offset tail piece	50
				1 hr. trucking	75
					19 93


\* 5.79 applied to meter rates:  
 acct B-96-3-233  
 " B-96-8-65  
 " B-96-10-681  
 5.79

DATE \_\_\_\_\_

TOWN OF LEXINGTON — BOARD OF PUBLIC WORKS

**WATER DIVISION**

Sketch of Service Here

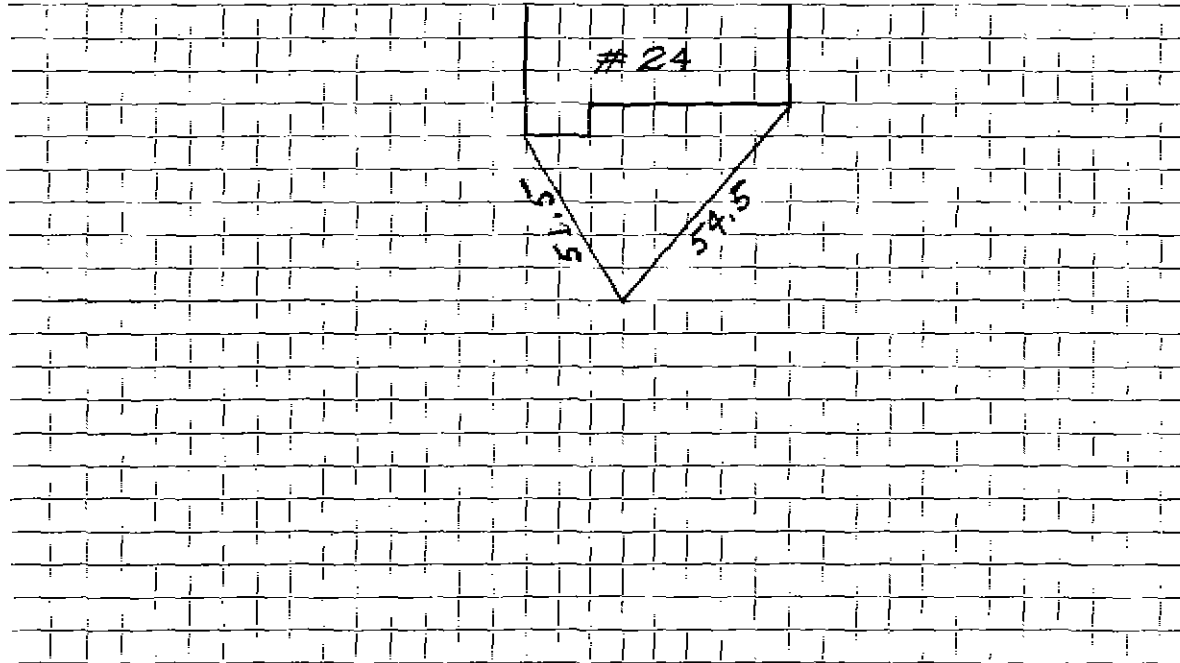

Connection made in ..... Street. Work completed .....

Remarks: .....

.....  
.....