

WATER SERVICE RECORD

Name Universal Builders, Inc.

Service No. 119

Address 26 Flintlock Road

Location

Repair ~~Renewal~~ - New Service

*Com 8-30-54*


| Date   | Material                             | Amount | Total | Date                         | Amount |
|--------|--------------------------------------|--------|-------|------------------------------|--------|
| 7/7/54 | Labor                                | 1 85   |       | 5-24-54                      | 30 00  |
|        | 10% overhead                         | 19     | 2 04  | 8-30-54                      | 18 96  |
|        | 55' - 3/4" copper tubing@.35         | 19 25  |       |                              | 26 04  |
|        | 1 - 3/4"C x 1/2" I.W.H. stop & waste | 4 00   |       |                              |        |
|        | 1 hr. trucking                       |        | 75    | 7/7/54                       | 1 71   |
|        |                                      |        | 26 04 | 10' - 3/4" copper tubing@.35 | 3 50   |
|        | TRENCH DUG BY OWNER:                 |        |       | 1 - 3/4"C. corp-cock         | 4 33   |
|        |                                      |        |       | 1 - 3/4"C. curb-cock         | 4 67   |
|        |                                      |        |       | 1 - box end rod              | 3 90   |
|        |                                      |        |       | 1 - 1/2" offset tail piece   | 50     |
|        |                                      |        |       | 1 - 1/2" straight tail piece | 50     |
|        |                                      |        |       | 1 hr. trucking               | 75     |
|        |                                      |        |       |                              | 19 86  |

*Deposited*  
*Refunded*  
NON CHARGE

DATE \_\_\_\_\_

**TOWN OF LEXINGTON — BOARD OF PUBLIC WORKS**  
**WATER DIVISION**

Sketch of Service Here

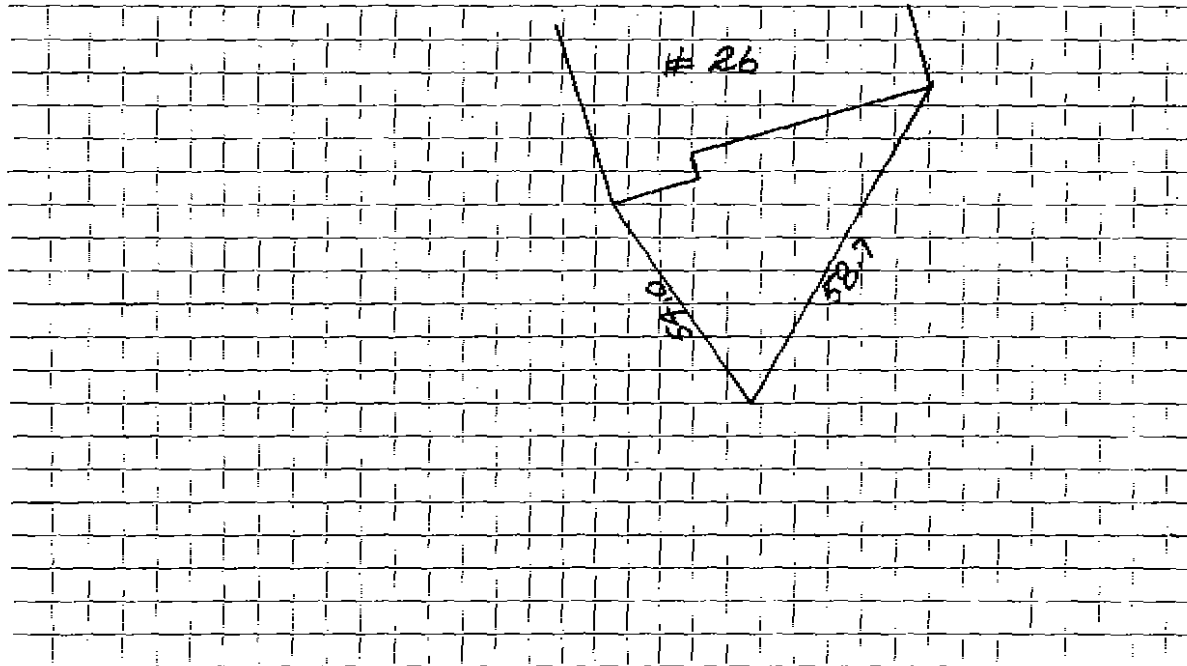

Connection made in ..... Street. Work completed .....

Remarks: .....

.....

.....