

WATER SERVICE RECORD

Service No. 150

Name E. S. Johnston

Address 27 Flintlock Road

Location

Comm. 9/30/57

~~Repair—Renewal—New Service~~

SERVICE WAS IN TO CURB


Date	Material	Amount	Total	Date	Amount	
7/26/57	Labor	3 45		7-24-57	Deposit	\$ 35 00
	10% overhead	35=	3 80	9-30-57	Refund	3 34
	53' - 3/4" Copper tubing @ .375		19 88		NON CHARGE	\$ 31 66
	1 - 3/4" Cx 1/2 I.W.H. Stop & Waste		4 96	7/26/57	1 - 1/2 Straight tailpiece	50
	1 - 3/4" Union (3 part)		2 27		1 - 1/2 Offset tailpiece	50
	1 hr. Trucking		75			1 00
			31 66			

DATE _____

TOWN OF LEXINGTON — BOARD OF PUBLIC WORKS

WATER DIVISION

Sketch of Service Here

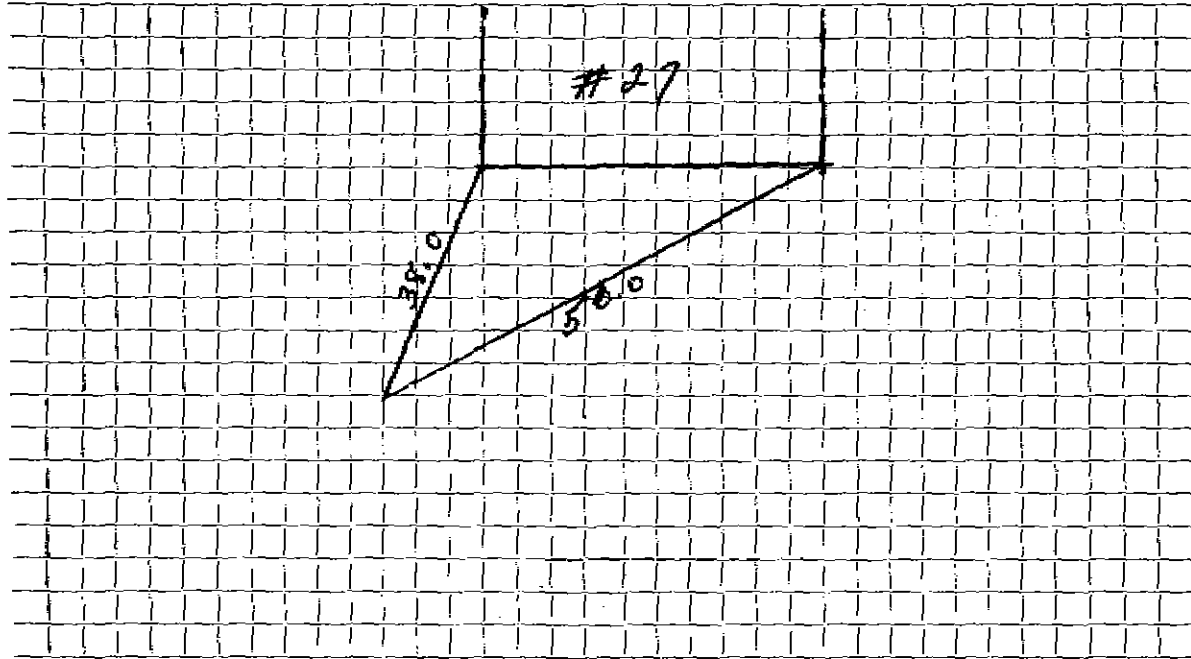

Connection made in Street. Work completed

Remarks:
.....
.....