

#2529
#2531

WATER SERVICE RECORD

Name Universal Builders, Inc.

Service No. 266

Address 3 Flintlock road

Location

Repair—Renewal—New Service

Cam 11-30-50

Date	Material	Amount	Total	Date	Material	Amount
12/28/53	Labor	2 90		9-7-53	<i>Supposed</i>	35 00
	20% Overhead	1 19	2 09	11-30-53	<i>Refunded</i>	2 49
	66' - 3/4" Copper tubing	1.3829	23 45		<i>ON ORDER</i>	32 51
	1 - 1/4" Gal. W.I. pipe/waste		4 50	11/12/55	Labor	1 90
	1 - 1/4" Gal. 1/4" C. union & gals.		1 72		66' - 1/4" Copper tubing	8 71
	1 hr. trucking		75		1 - 1/4" Gal. pipe-elbow	4 50
			<u>35 51</u>		1 - 1/4" Gal. pipe-elbow	4 50
					1 hr. labor	3 90
					1-1/2 straight tail piece	50
					1-1/2 offset tail piece	50
					1 hr. trucking	75
						<u>25 26</u>


UNIVERSAL BUILDERS

DATE _____

TOWN OF LEXINGTON — BOARD OF PUBLIC WORKS

WATER DIVISION

Sketch of Service Here

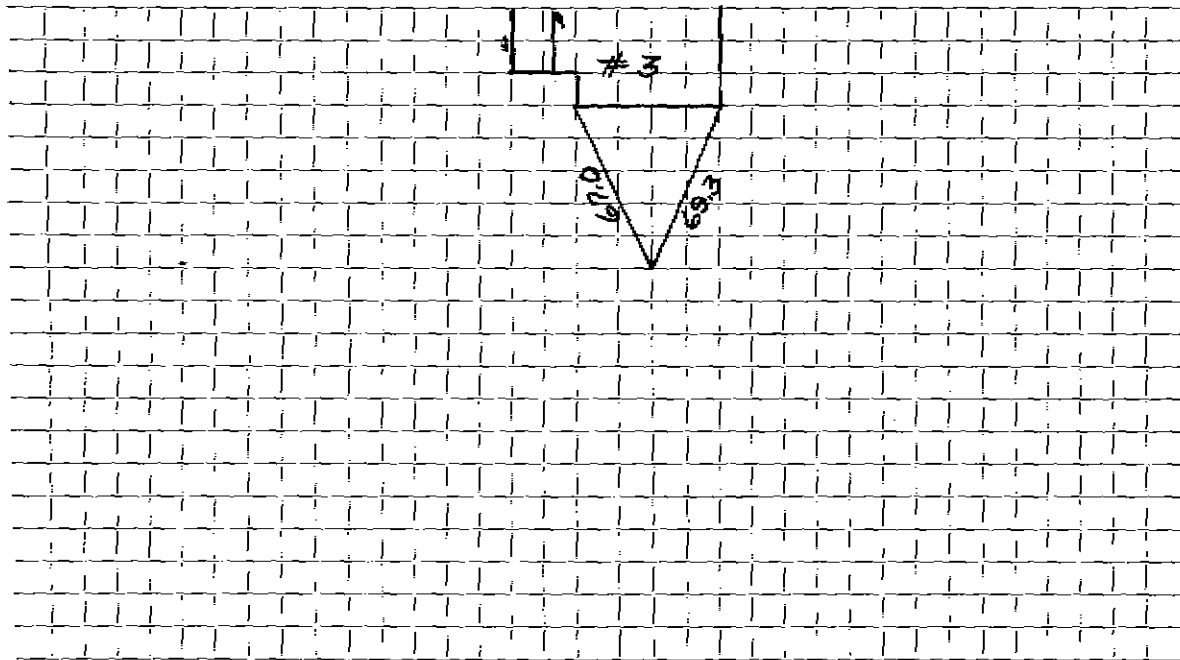

Connection made in Street. Work completed

Remarks:

.....

.....