

5849

WATER SERVICE RECORD

Name Universal Builders, Inc. Service No. 267
Address 4 Flintlock Road
Location

~~Repair - Renewal - New Service~~

Contra 11-23253


Date	Material	Amount	Total	Date		Amount
10/22/53	Labor	1.75		10/22/53	Deposited	.35 00
	10% overhead	18	1193	10/23/53	Refunded	(11.99)
	45' -5/4" copper tubing @ .3629	16.33			NO CHARGE	23.01
	1 - 5/4" C x 1/2 I.I.H. stone waste	4.00	10/23/53	Labor		3.70
	1 hr. trucking	.75	6' -3/4" copper tubing @ .3629		2.18	
		23.01	1 - 1-1/4" C. corr-cock		4.53	
	BRUSH DUG BY AREA	"	1 - 3/4" C x 3/4" C. curb-cock		4.67	
		"	1 box ard rod		3.90	
		"	1 - 1/2 offset tail pc.		.50	
		"	1 - 1/2 straight tail pc.		.50	
		"	1 hr. trucking		.75	
					20.53	

DATE _____

TOWN OF LEXINGTON — BOARD OF PUBLIC WORKS

WATER DIVISION

Sketch of Service Here

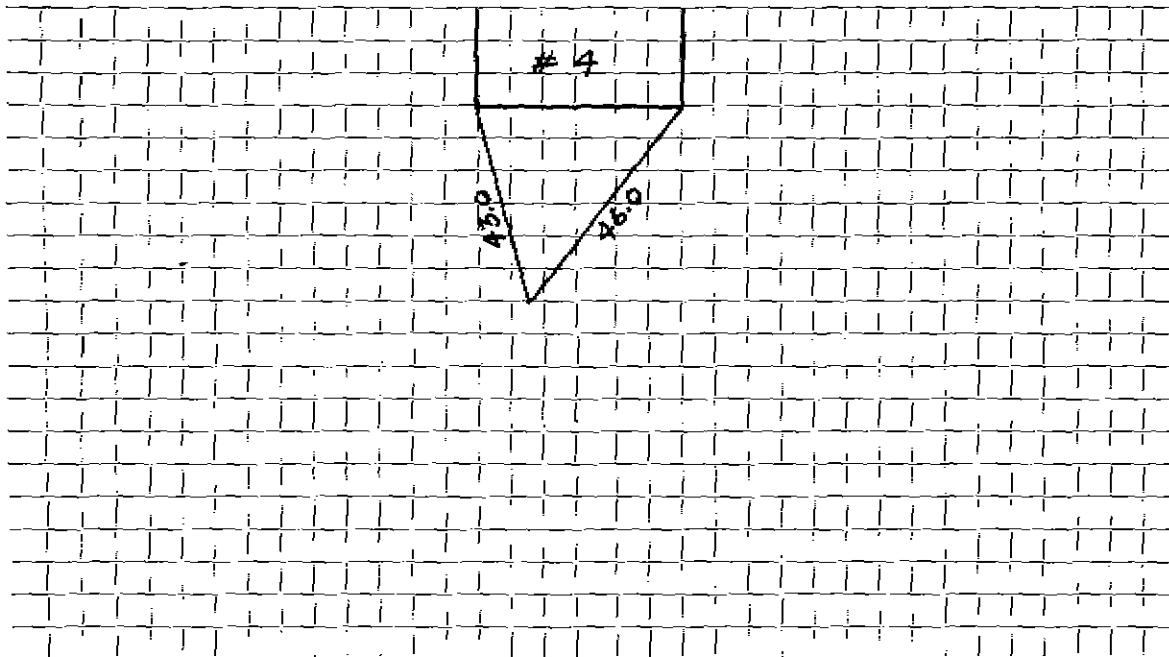

Connection made in Street. Work completed

Remarks:

.....

.....