

**WATER SERVICE RECORD**

# 985


Name	Universal Builders, Inc.	Service No.	321
Address	5 Flirtlock Road		
Location			
Rep/CO Name/EX	New Service	Com	11-23-33
Date	Material	Amount	Total
11/4/33	Labor	11.75	
	10% overhead	1.8	13.93
	42' - 3/4" copper tubing	3.628	14.88
	1 - 3/4" C x 1.25" stop & waste	4.00	
	1 hr. trucking	1.75	
		21.56	
			36' - 3/4" copper tubing
			3.628
			1 - 3/4" C. corp-cock
			1 - 3/4" C x 3/4" 2. curb-cock
			1 box sand rad
			1 - offset tail pc.
			1 - straight tail pc.
			1 hr. trucking
			75
			34.89

DATE \_\_\_\_\_

TOWN OF LEXINGTON — BOARD OF PUBLIC WORKS

**WATER DIVISION**

Sketch of Service Here

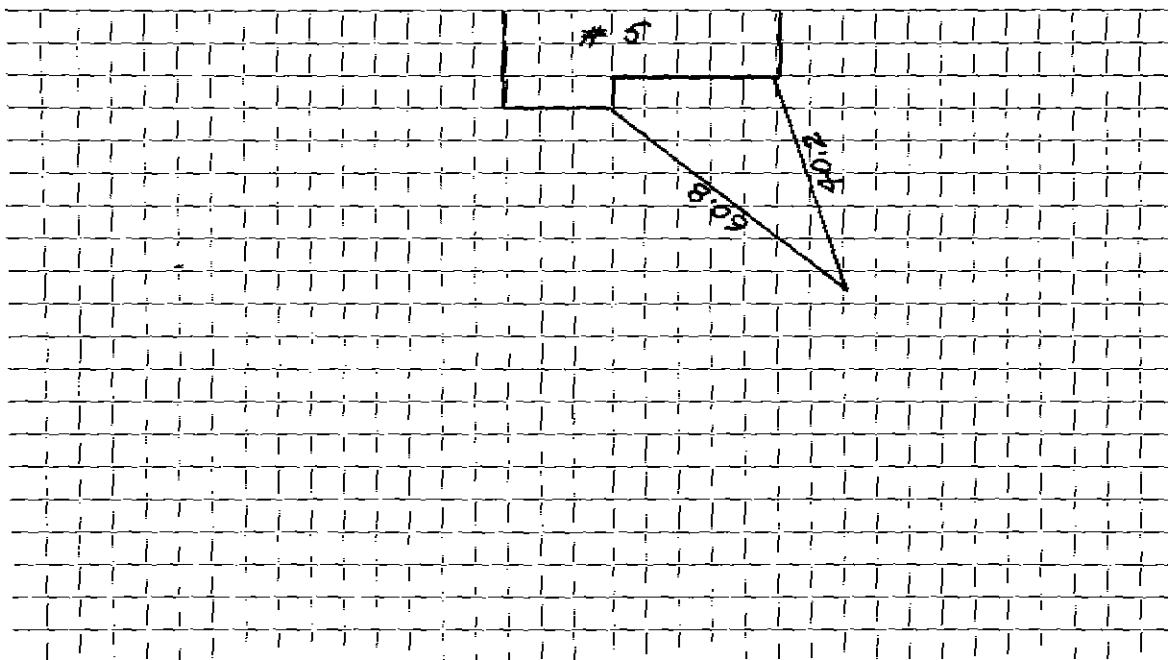

Connection made in ..... Street. Work completed .....

Remarks: .....

.....

.....