

WATER SERVICE RECORD

Name Universal Builders, Inc.

Service No. 289

Address 6 Flintlock Road

Location

Repair - ~~Renewal~~ - New Service

Cons 11-23-53


Date	Material	Amount	Total	Date	Amount
10/22/53	Labor	1 75		9-16-53	Deposited 25 00
	10% overhead	18	1 93	11-23-53	Refunded 10 17
	50' - 3/4" copper tubing	2 3629	18 15		<u>NON CHARGE</u> 24 83
	1 - 3/4" C x 3/4" I.W.E. stop & waste	4 00		10/22/53	Labor 3 70
	1 hr. trucking		75		10' + 3/4" copper tubing 2 63
			24 83		1 - 3/4" C. corp-cock 4 33
	SMOOTH TIG 57 OPER:				1 - 3/4" C x 3/4" curb-cock 4 67
					1 hot end rod 3 90
					1 - offset tail pc. 50
					1 - straight tail pc. 50
					1 hr. trucking 75
					<u>21 98</u>

DATE _____

TOWN OF LEXINGTON — BOARD OF PUBLIC WORKS

WATER DIVISION

Sketch of Service Here

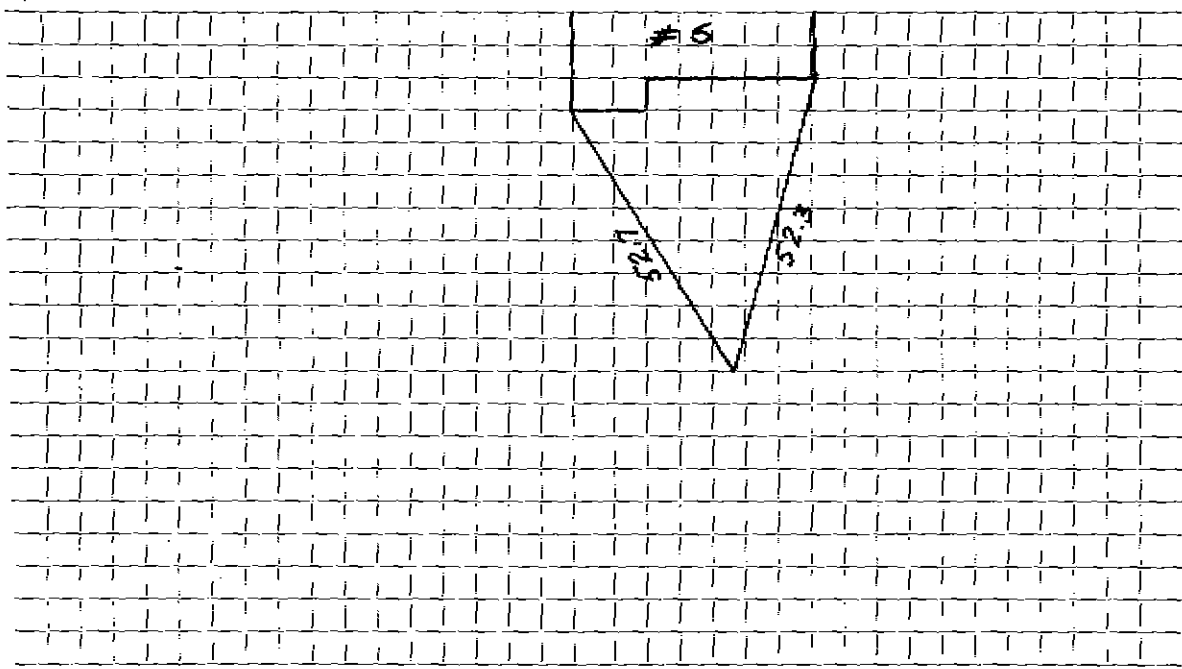

Connection made in Street. Work completed

Remarks:
.....
.....