

WATER SERVICE RECORD

Name Universal Builders, Inc.

Service No. 290

Address 8 Flintlock Road

Location

Repair ~~REPAIR~~ - New Service


Am. 11-23-53

Date	Material	Amount	Total	Date	Amount
10/22/53	Labor	1 75		7-16-53	Deposited 25 00
	100% overhead	18	1 93	11-23-53	Refunded (11 99)
	45' - 3/4" copper tubing @ .3629	16 33			<u>23 01</u>
	1 - 3/4" C x 1/4" L.R. stop cock	4 00		10/22/53	Labor 3 70
	1 hr. trucking		75	10'	3/4" copper tubing @ .3629 3 63
			23 01	1 - 3/4" c. curb-cock	4 35
	TRUCKING CHG BY 1 PER:			1 - 3/4" C x 1/4" c. curb-cock	4 67
				1 cock and rod	3 90
				1 - offset tail pc.	50
				1 - straight tail pc.	50
				1 hr. trucking	75
					<u>21 28</u>

DATE _____

TOWN OF LEXINGTON — BOARD OF PUBLIC WORKS
WATER DIVISION

Sketch of Service Here

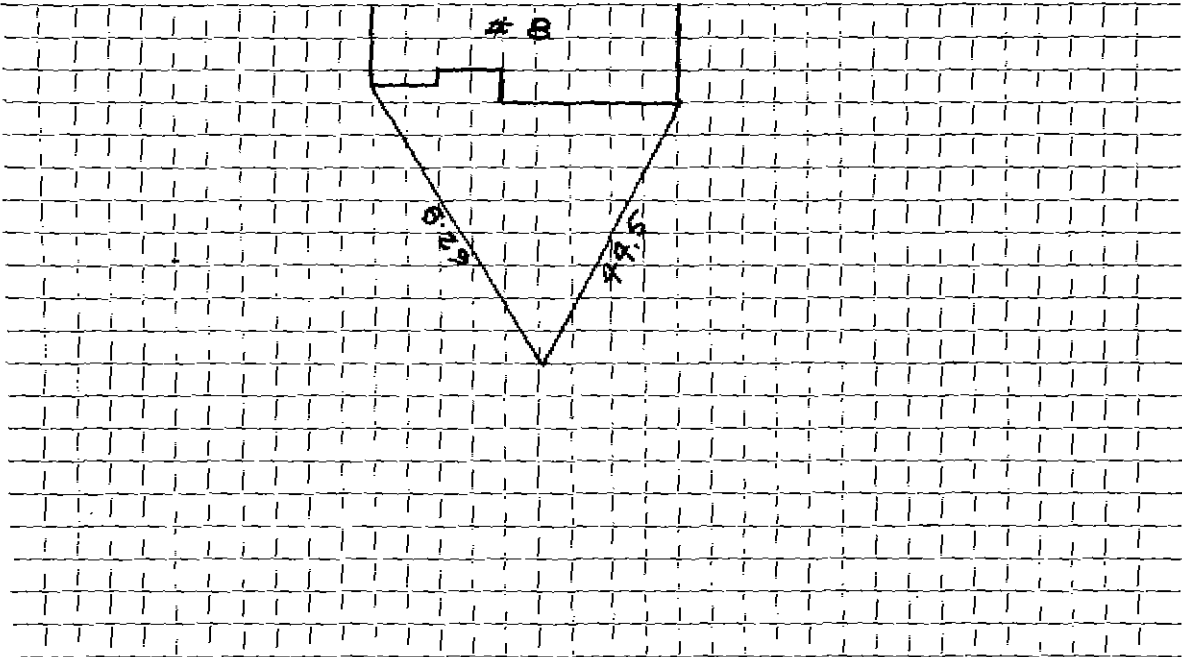

Connection made in Street. Work completed

Remarks:
.....
.....