

WATER SERVICE RECORD

#7009

Name Universal Builders, Inc.

Service No. 323

Address 9 Flintlock Road

Location

Repair: ~~TRENCH~~ - New Service

Comm. 11-23-53


Date	Material	Amount	Total	Date	Amount
11/4/53	Labor	1 75		10-14-53	Deposited 35 00
	10% overhead	18	1 93	11-23-53	Refunded (14 89)
	37' - 3/4" copper tubing @.3629	13 43			<u>NON CHARGE</u> 20 11
	1 - 3/4" C x 1/2 I.W.H. stop & waste	4 00		11/4/53	Labor 7 19
	1 hr. trucking		75		24' - 3/4" copper tubing @.3629 8 71
			20 11		1 - 3/4" C. corp-cock 4 53
	TRENCH DUG BY OWNER:				1 - 3/4" C x 3/4" C. curb-cock 4 67
					1 box and rod 3 90
					1 - 1/2 offset tail pc. 50
					1 - 1/2 straight tail pc. 50
					1 hr. trucking 75
					30 55

DATE _____

TOWN OF LEXINGTON — BOARD OF PUBLIC WORKS

WATER DIVISION

Sketch of Service Here

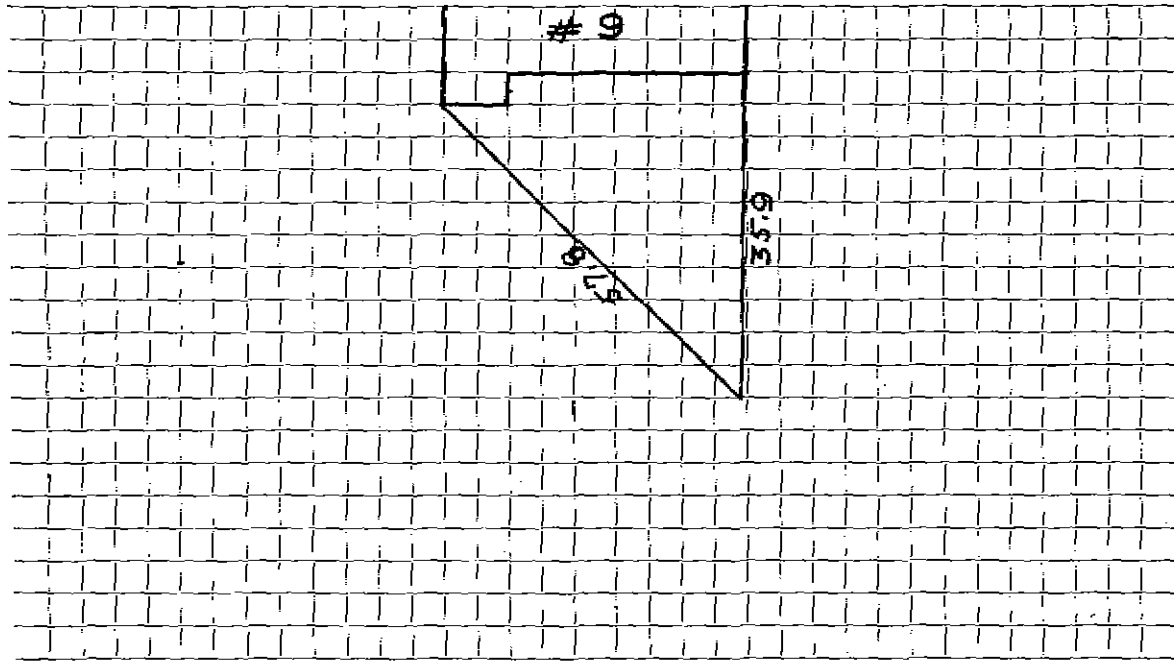

Connection made in Street. Work completed

Remarks:

.....
.....