

Name W. S. Couette

Service No. ~~87~~ 925

Address Lexington, Mass.
Follen Hill Development
Location

Water Service for Office at Follen Hill Development

Kind of Pipe Size Size of Main
Repair—Renewal—New Service Location

Date 1941	Material	Amount	Total	Date	Location	Amount
June 26	5 hrs. @ 60¢	3 00	3 00	Jan 30 1942	Paid	19 11
Com 12/24/41	10% Overhead		30			
	7' 3/4" Copper tubing @ 19¢		1 33			
	1 3/4" C x I. Union 2 part		70			
	1 1" x 3/4" L.L. Elbow		19			
	1 1" x 3/4" Reducing coupling		30			
	1 1" L.L. Elbow		26			
	1 1" Space Nipple		31			
	3' 1" C.L. Pipe @ 19¢		57			
	1 pit cover		4 48			
	Trench repairs		7 67			
			19 11			
	Labor					

Hadley Press, Inc., Lexington

DATE _____

TOWN OF LEXINGTON—BOARD OF PUBLIC WORKS

WATER DIVISION

The undersigned applies for a supply of water at No. _____ St. and hereby agrees to comply with the rules and regulations as now, or at any future time, established by the Board of Selectmen.

Am't. of Estimate \$ _____


Owner _____

Am't. Paid \$ _____

Address _____

Builder _____

Sketch of Service Here

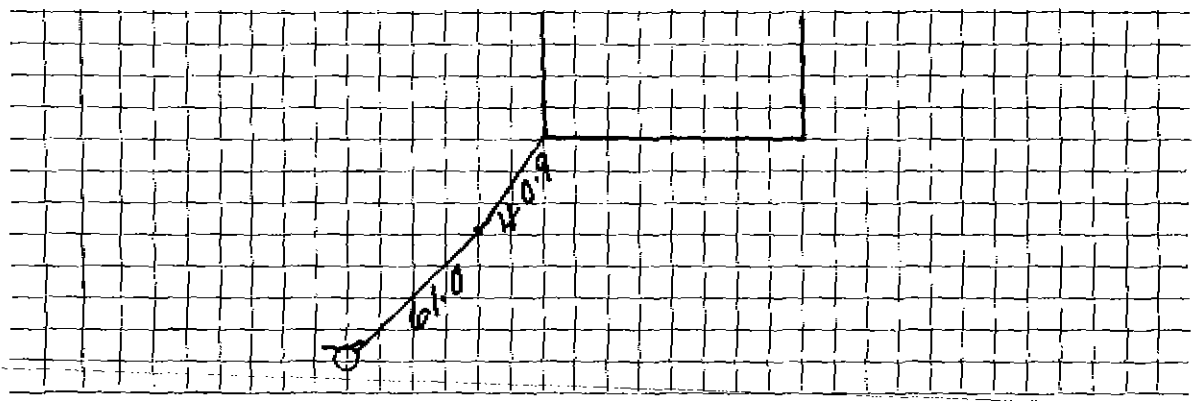

Connection made in _____ Street.

Work completed _____ 19

Remarks: