

WATER SERVICE RECORD

Name Helen Kelley

Service No. 43

Address 103 Follen Road

Location

~~Revised~~ ~~Received~~ - New Service W.O. #8588

Comm 8-18-64


Date	Material	Amount	Total	Date	Amount	
4-3-64	Labor	54.63		3-16-64	Deposit	250.00
	10 $\frac{3}{4}$ C.H.	5.46	60.09	5-18-64	Retard	116.29
	60' 3/4" Copper tubing @.42		25.20			133.71
	1 3/4" C x $\frac{1}{2}$ I.W.H. Stop & Waste		6.17		NON CHARGE	
	15 x 3 Patch		15.00	4-3-64	Labor	13.66
	2 $\frac{1}{2}$ hrs. Town Shovel @6.50		16.25		15' 3/4" Copper tubing @.42	6.30
	2 hrs. Trucking @3.00		6.00		1 3/4" C Corp Cock	4.91
	1 hr. Loader @5.00		5.00		1 3/4" C Curb Cock	6.28
			133.71		1 Box & Rod	4.90
					1 $\frac{1}{2}$ Straight tailpiece	.50
					1 $\frac{1}{2}$ Offset tailpiece	.50
					$\frac{1}{2}$ hr. Town Shovel @6.50	3.25
						40.30

DATE _____

TOWN OF LEXINGTON — BOARD OF PUBLIC WORKS

WATER DIVISION

Sketch of Service Here

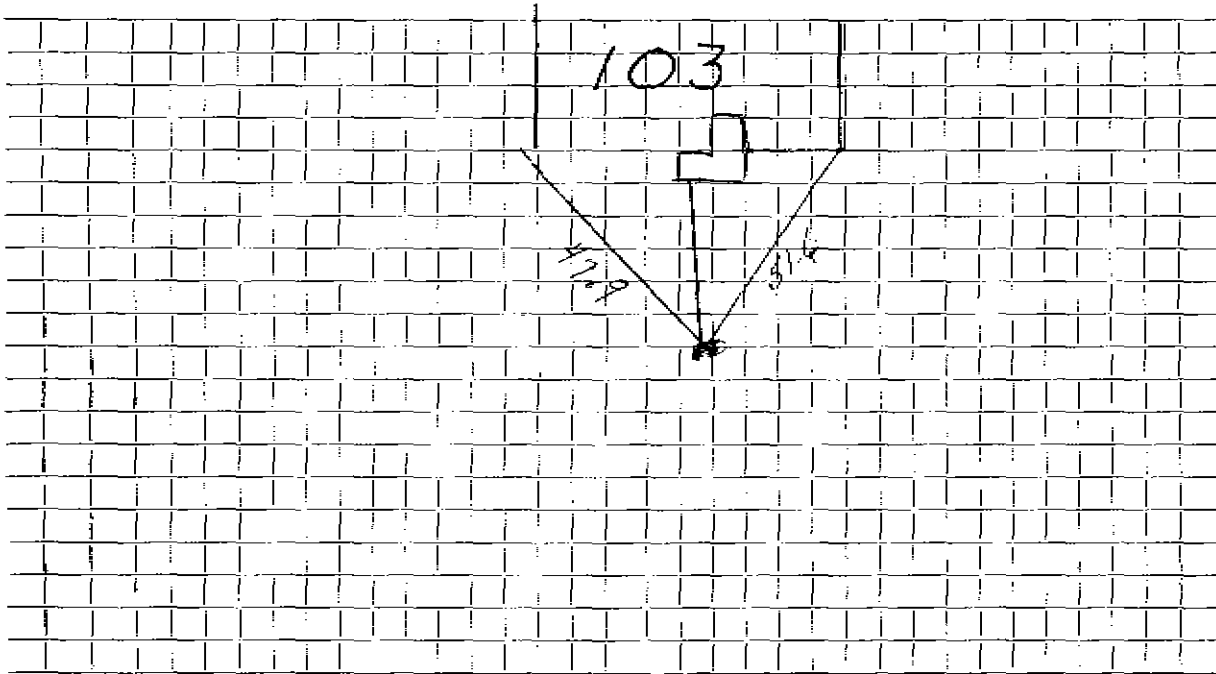

Connection made in Street. Work completed

Remarks:

.....

.....