

WATER SERVICE RECORD

Name S.R. Smith

Service No. _____

Address 104 Follen Road

Location _____

~~Repair~~ ~~Renewal~~ New Service


Comm 12-1-47

Date	Material	Amount	Total	Date		Amount
9/4/47	Labor	1. 10		8-13-47	Deposit	50. 00
	10% O.H.	11	1. 21	9-4-47		2. 5
54'	3/4" Copper tubing @.26		14. 04			20. 47
1	3/4" C x 1/2" I.W.H. Stop & Waste		3. 15		OUTSIDE	
1	3/4" C x 3/4" C Union (3 pts)		. 32	9/4/47	Labor	1. 10
1	hr. Trucking @.75		75		10' 3/4" Copper tubing @.26	2. 60
			20. 47		1 3/4" C orp Cock	3. 00
					1 3/4" C x 3/4" Curb Cock	3. 68
					1 Box & Rod	4. 26
					1 1/2" Offset tail piece	. 50
					1 hr. Trucking @.75	. 75
						15. 69

DATE _____

TOWN OF LEXINGTON -- BOARD OF PUBLIC WORKS
WATER DIVISION

Sketch of Service Here

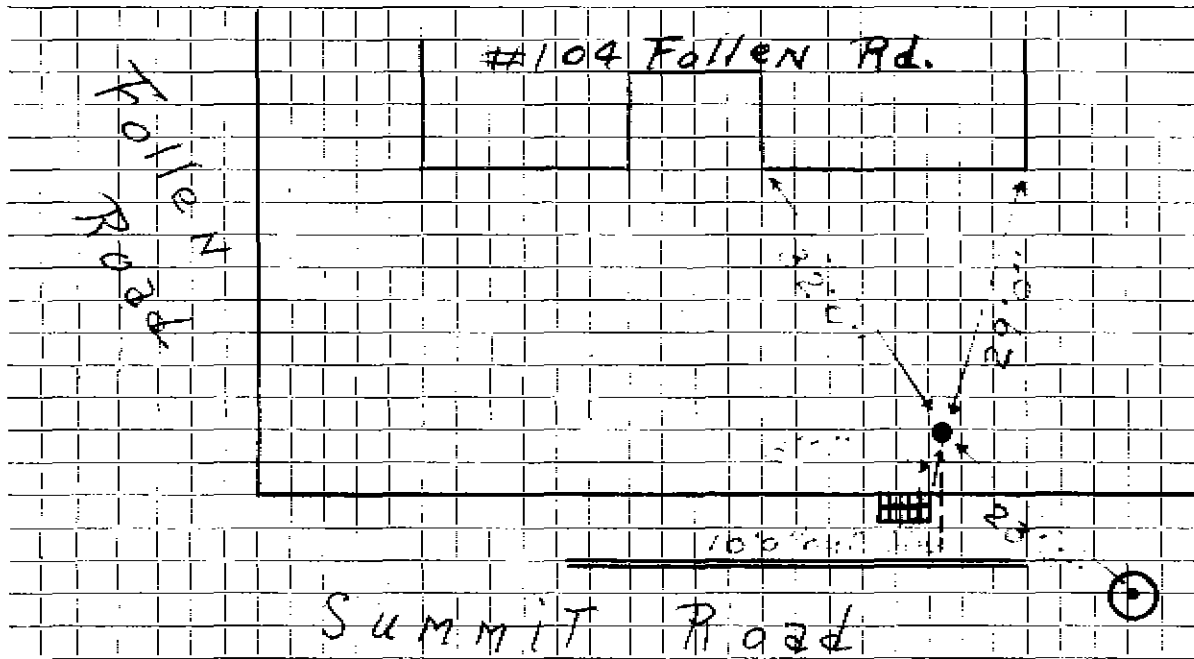

Connection made in Street. Work completed

Remarks:

.....

.....