

Name Clarence H. Conroy

Service No. ~~8~~ 906

Address 11 Cypress Rd., Arlington
120 Follen Rd.

Location ~~Cor. Summit &~~ Follen Rds. #120 Follen Rd

Kind of Pipe

Size

Size of Main

~~REPAIR - REHABILITATION~~ - New Service

Location

Date	Material	Amount	Total	Date	Amount
1936					
Jan. 15	36' 1" C.L. Pipe @ 27¢	\$9 72		Jan 9 1936	12 50
	2 1" L.L. Coup @ 18¢	36		Deposited	
	1 S. & W.	<u>1 75</u>			
			\$11 83		
	Say: \$12.00				
	Labor on sewer service slip.				
	Labor				

Indley Press, Inc., Lexington

DATE December 30-1935

TOWN OF LEXINGTON—BOARD OF PUBLIC WORKS

WATER DIVISION

The undersigned applies for a supply of water at No. Lot A. Summit Falls Rd. and hereby agrees to comply with the rules and regulations as now, or at any future time, established by the Board of Selectmen.

Am't. of Estimate \$ 12⁰⁰


Owner Blair H. Brown

Am't. Paid \$ _____

Address 11 Cypress Road
Arlington, Mass.

Builder Blair H. Brown

Sketch of Service Here

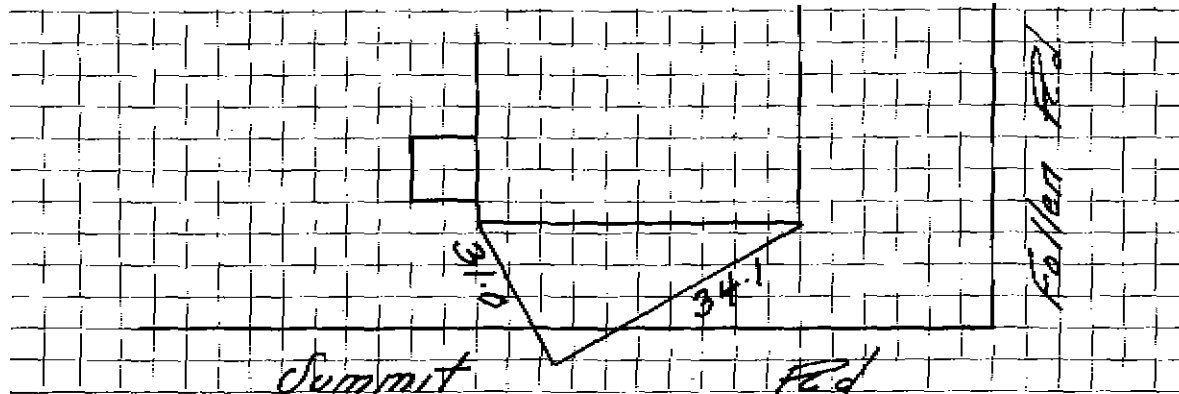

Connection made in _____ Street.

Work completed _____ 19

Remarks: