

**WATER SERVICE RECORD**

Name John J. McIlreer

Service No. 47

Address 121 Follen Road

# 3880

Location

~~Repair—Renewal—New Service~~

W.O. # 6928

DEC 22 1949


Date	Material	Amount	Total	Date	Amount
10/10/49	Labor		20 46	10-2-49	Deposit 175 00
	10% O.M.		2 05	12-22-49	Refund 183 12
33'	3/4" Copperpipe .79		26 07		71 88
1	3/4" Wheel Valve		9 30		<u>OUTSIDE</u>
1	Hrs. Trucking		3 00	10/22/49	Labor 20 46
1	Hired shovel		11 00	11/1/49	10 10
			71 88		11' 3/4" Copperpipe .79 11 00
					3/4" Gate cock 1 00
					3/4" Adapter 1 00
					Ten cold water 5.25 1 43
					Yd. lawn 3.50 1 71
					12. grass seed 1 10
					Ten hot tap 5.25 2 03
					Hrs. trucking 1 50
				2	Hrs. trucking 3.00 6 00
				2	" DeFlice shovel 11.00 23 00
				1	" Compressor 5.00 2 50
				1	" roller 2.00 1 50
					Trailer 2 00
					107 46

DATE \_\_\_\_\_

TOWN OF LEXINGTON — BOARD OF PUBLIC WORKS

**WATER DIVISION**

Sketch of Service Here

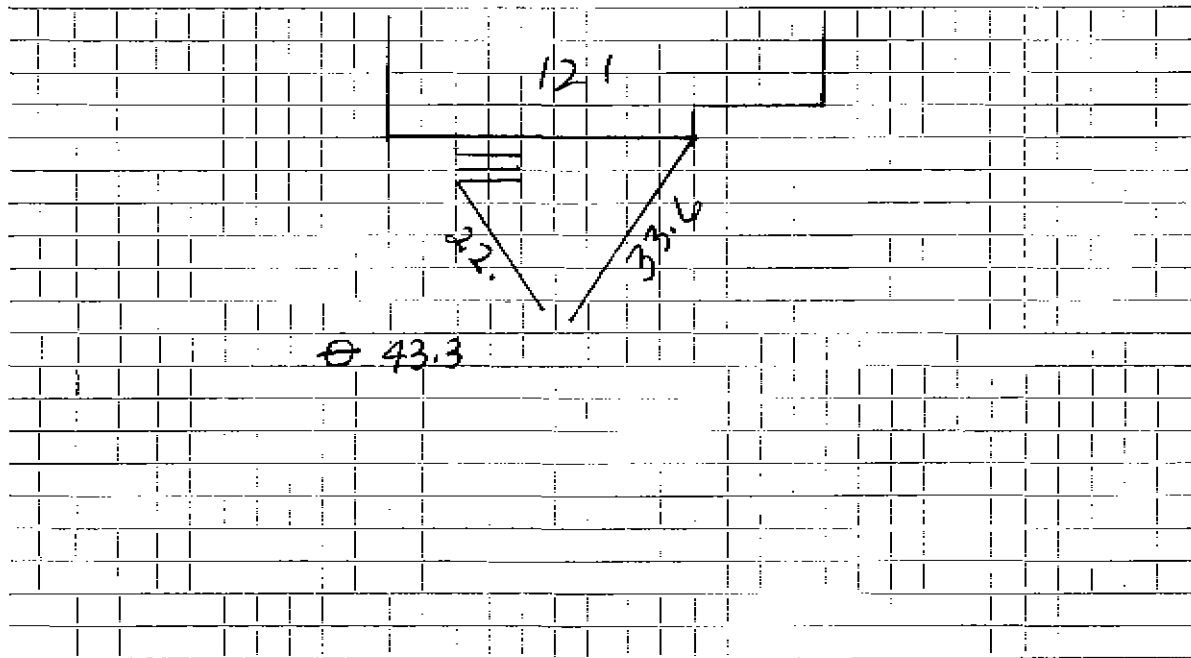

Connection made in ..... Street. Work completed .....

Remarks: .....

.....  
.....