

Name Ernest Cutter

Service No. 241

Address 127 Follen Road
Lexington, Mass.

Location 127 Follen Road

Kind of Pipe

Size

Size of Main

~~Repair~~ ~~Renewal~~ ~~New Service~~

Com. 12-13-49

Location

| Date | Material | Amount | Total | Date | Amount |
|--------------|--------------------------------|--------|-------|----------------------------------|--------|
| Nov. 19, '49 | Labor | 1 30 | 1 30 | | |
| | 10% Overhead | | 13 | | |
| | 36' - 3/4" Copper Tubing @ .24 | | 8 64 | | |
| | 1 - 3/4" C x 1/2" I. W.R. S&W | | 3 29 | | |
| | Trucking 1 hr. @ .75 | | 75 | | |
| | | | 14 11 | | |
| | | | | Nov. 19, '49 | 3 60 |
| | | | | 10' - 3/4" Copper Tubing @ .24 | 3 12 |
| | | | | 1 - 3/4" C Corp-cock | 3 15 |
| | | | | 1 - 3/4" C x 3/4" C Curb-cock | 3 85 |
| | | | | 1 - Box " Rod | 3 75 |
| | | | | 1 - 1/2" Offset Tail Piece | 37 |
| | | | | 1 - 3/8" Straight Tail Piece | 37 |
| | | | | Littlefield Shovel 2 hrs. @ 7.00 | 14 00 |
| | | | | Trucking 1 hr. @ .75 | 75 |
| | Labor | | | | 32 95 |

No Deposit
March 17, 1952
Procted
No Charge

2 1/2 hrs. @ .75

DATE _____

TOWN OF LEXINGTON - BOARD OF PUBLIC WORKS

WATER DIVISION

The undersigned applies for a supply of water at No..... St. and hereby agrees to comply with the rules and regulations as now, or at any future time, established by the Board of Selectmen.

Am't of Estimate \$.....

Owner


Am't Paid \$.....

Address

Builder

.....

Sketch of Service Here

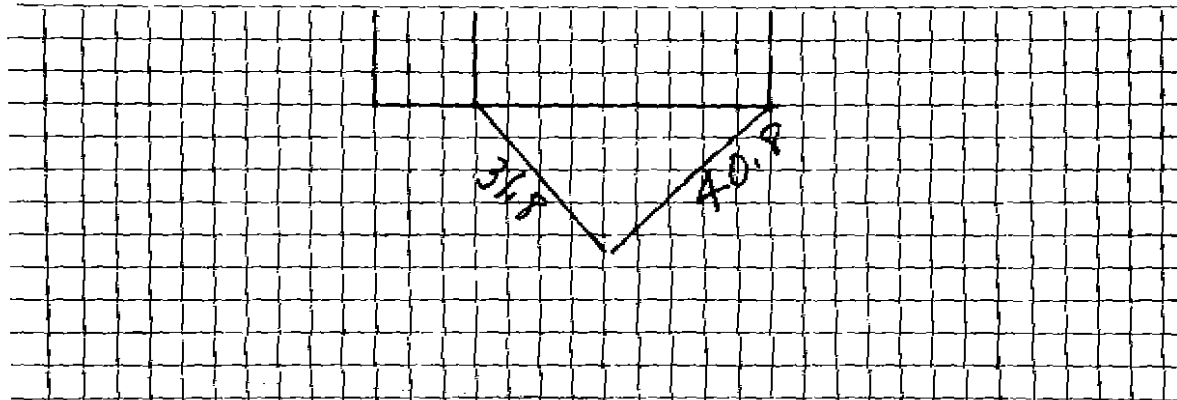

Connection made in Street.

Work completed19

Remarks: