

## WATER SERVICE RECORD

1110

Name Herbert Siegert

Service No. 5

Address 132 Follen Road

Location

~~RENEWAL~~—Renewal—~~NOT SERVICE~~ W.O. #8551


Conn 5-18-64

Date	Material	Amount	Total	Date	Amount
3-27-64	Labor	103.85		2-5-64	Deposit 150.00
	10% O.H.	10.39	114.24	5-28-64	Paid 59.27
	62' 3/4" Copper tubing @.42		26.04		<u>209.27</u>
1	3/4" C x 1/2 I.W.H. Stop & Waste		6.17		NON CHARGE
2	3/4" C 3 part Unions @2.41		4.82	3-27-64	Labor 51.99
7	yards Loam @3.00		21.00	31'	3/4" Copper tubing @.42 13.02
4	hrs. Town Shovel @6.50		26.00	1	3/4" C Curb Cock 6.28
1	hr. Compressor @5.00		5.00	1	3/4" Adapter 1.62
2	hrs. Trucking @3.00		6.00	1	1/2 Straight tailpiece .50
			209.27	1	1/2 Offset tailpiece .50
				24	x 3 Patch 24.00
				3	hrs. Town Shovel @6.50 19.50
				1	hr. Trucking @3.00 <u>3.00</u>
					120.41

DATE \_\_\_\_\_

TOWN OF LEXINGTON — BOARD OF PUBLIC WORKS  
**WATER DIVISION**

Sketch of Service Here

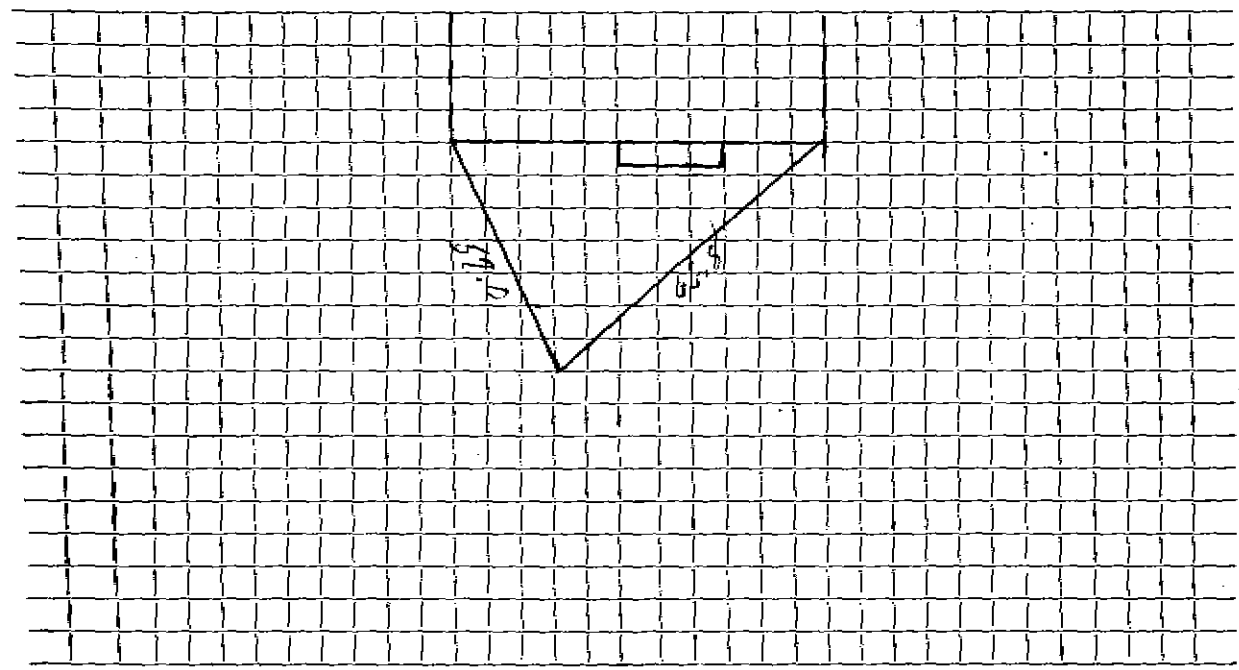

Connection made in ..... Street. Work completed .....

Remarks: .....  
.....  
.....