

WATER SERVICE RECORD

Name *Holmes Realty Corp.*

Service No. _____

Address *135 Follen Road*

Location _____


Repair—Renewal—New Service *E.R. Banks*

| Date | Material | Amount | Total | Date | Material | Amount |
|----------------|------------------------------|--------|-------|----------------|-----------------------------|--------|
| <i>8/12/89</i> | <i>47'6" 1" Copper</i> | | | | | |
| | <i>1 1" Three Part Union</i> | | | | | |
| | | | | | <i>OUTSIDE</i> | |
| | | | | <i>4/14/89</i> | <i>15' 1" Copper</i> | |
| | | | | | <i>1 1" Corp</i> | |
| | | | | | <i>1 1" Curb</i> | |
| | | | | | <i>1 Curb Box & Rod</i> | |

DATE _____

TOWN OF LEXINGTON — BOARD OF PUBLIC WORKS

WATER DIVISION

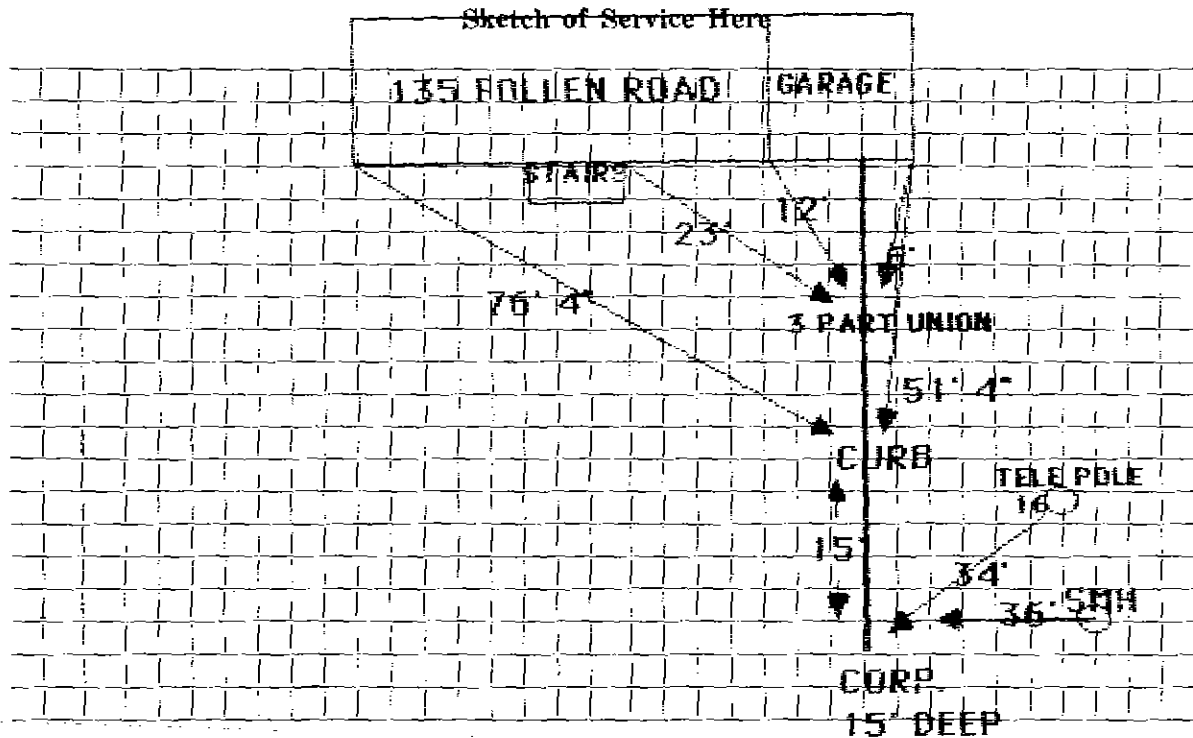

Connection made in Street. Work completed

Remarks:
.....
.....