

Name

Service No. 910

Address 142 Follen Rd.

#7185

Location 142 Follen Rd

Kind of Pipe

Size

Size of Main

Repair—Renewal—New Service

Location

Date

Material

Amount

Total

Date

Amount

Labor

DATE _____

TOWN OF LEXINGTON—BOARD OF PUBLIC WORKS

WATER DIVISION

The undersigned applies for a supply of water at No. _____ St. and hereby agrees to comply with the rules and regulations as now, or at any future time, established by the Board of Selectmen.


Am't. of Estimate \$ _____

Owner J. F. Wilkins

Am't. Paid \$ _____

Address 142 Follen Rd.

Builder _____

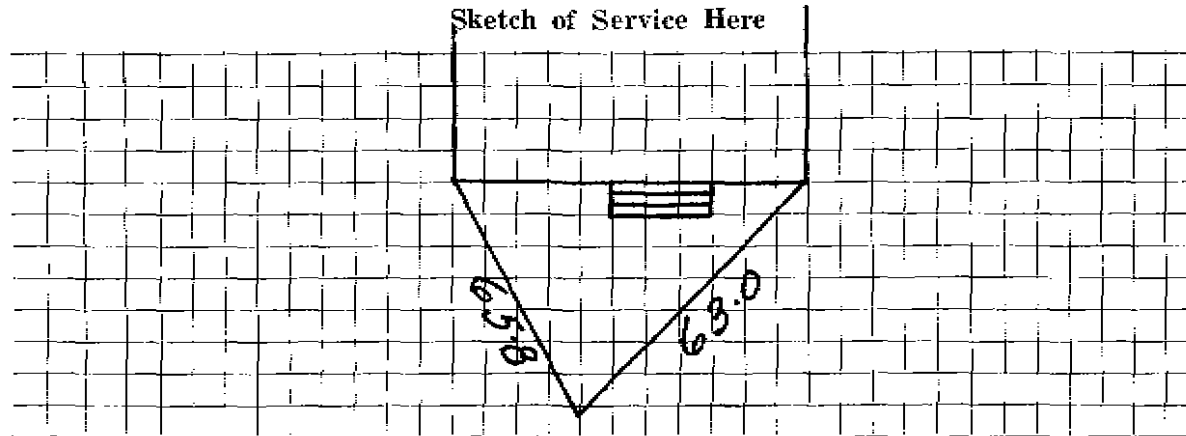

Connection made in _____ Street.

Work completed _____ 19

Remarks: