

WATER SERVICE RECORD

Name Abraham Zaleznik

Service No. 192

Address 151 Follen Road

Location

Repair—~~Repair~~ New Service

Comm. 11-18-57


| Date | Material | Amount | Total | Date | Amount |
|--------|--|--------|-------|----------|--------------------------------------|
| 9/3/57 | Labor | 1 76 | | 9-3-57 | Deposit 50 00 |
| | 10% overhead | 18 | | 11-18-57 | Refund 19 85 |
| | | 1 94 | 1 94 | | \$ 30 15 |
| | 60' 3/4" copper tubing @.375 | 22 50 | | | NON CHARGE |
| | 1 3/4" Cx $\frac{1}{2}$ IWH stop & waste | 4 96 | | | Labor 3 52 |
| | 1 hr. trucking @.75 | 75 | | | 18' 3/4" copper tubing@.375 6 75 |
| | | | 30 15 | | 1 3/4" C corp cock 5 94 |
| | | | | | 1 3/4" C curb cock 4 64 |
| | | | | | 1 box & rod 4 62 |
| | | | | | 1 $\frac{1}{2}$ straight tail pc. 50 |
| | | | | | 1 $\frac{1}{2}$ offset tail pc. 50 |
| | | | | | 26 47 |

DATE _____

TOWN OF LEXINGTON — BOARD OF PUBLIC WORKS

WATER DIVISION

Sketch of Service Here

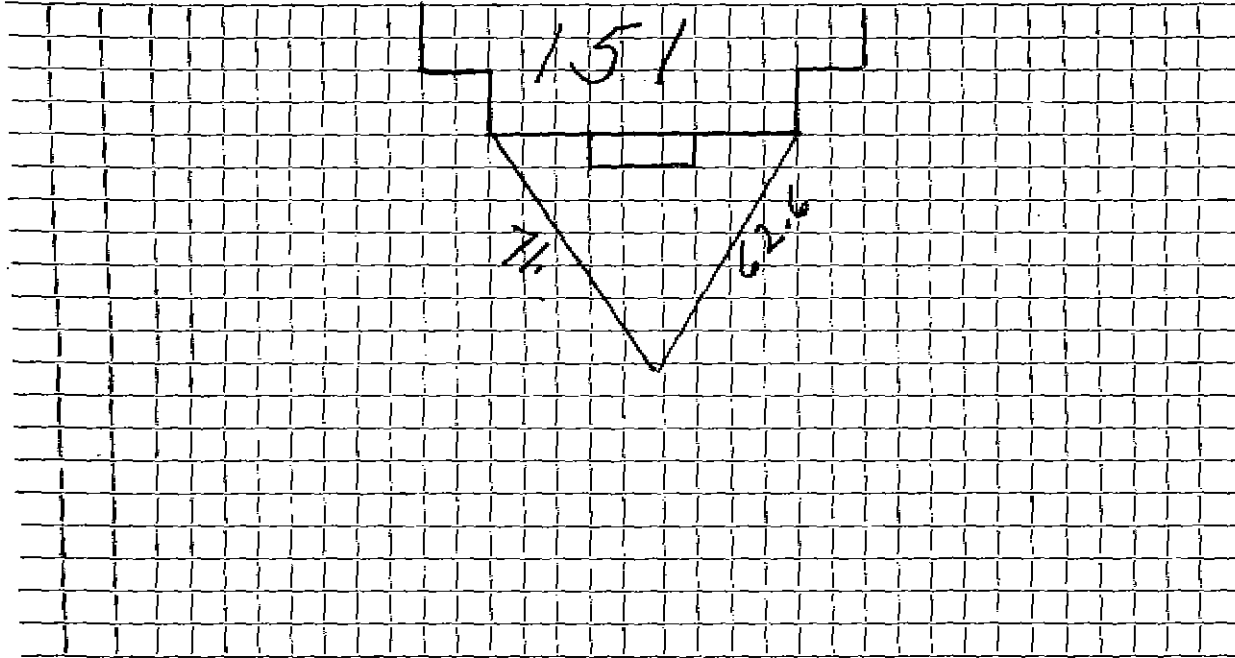

Connection made in Street. Work completed

Remarks:

.....

.....