

WATER SERVICE RECORD

Name DAVID AND LYNN GARVIN

Service No. _____

Address 182 FOLLER RD.

Location _____

Repair—Renewal—New Service


McKee #440

Date	Material	Amount	Total	Date	Amount
6	5/8 90' 1" copper pipe			6-18-80	
				3' 1" Copper	
				1 1" Brass Nipple	
				1 1" Brass C. To 1. adapter	
				1 1"-3 Part Union	
				1 2" X 1" LL Reducer	
				1 1 1/2" X 2" Brass Reducer	

DATE 6-5-95

TOWN OF LEXINGTON — BOARD OF PUBLIC WORKS
WATER DIVISION

Sketch of Service Here

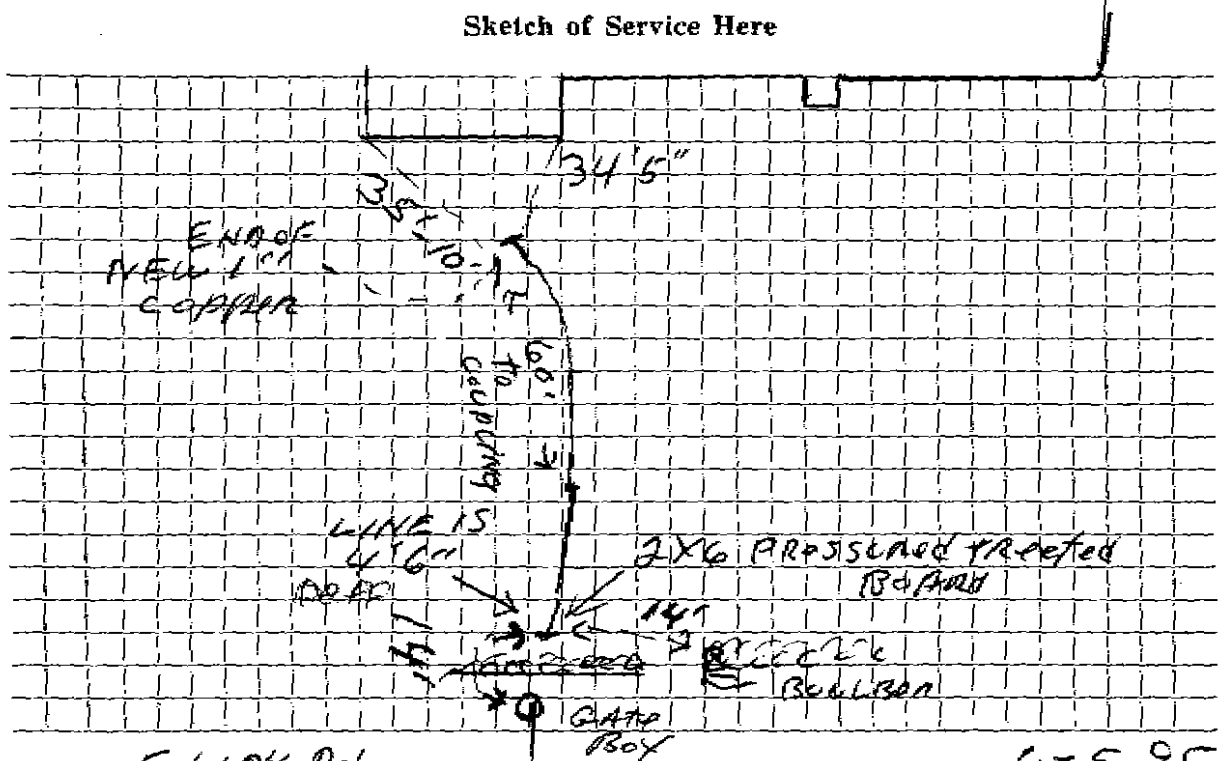

Connection made in FOLLOW RD Street. Work completed 6-5-95

Remarks: THIS IS A NEW 1" COPPER LINE FOR THE FUTURE WHEN
NEEDED TO REPLACE OLD SERVICE

Bruce J. McKee