

Name Custance, T. A. Builder (Owner-Geo. L. Faulkner)

Service No. ~~58~~ 916

Address 193 Follen Road

#7087

193
Location ~~136~~ Follen Road

Kind of Pipe

Size

Size of Main

Repair—Renewal—New Service

Location

Date	Material	Amount	Total	Date	Amount
1937					
7/21/37	2 hrs @ 60¢		1 20	October 28, 1937	23 50
<i>Jan 9 1937</i>	47' 1" Copper Tubing @ 30¢		14 10	Paid	
	1 1" Stop & Waste		3 75		
	2 hrs. Trucking @ 75¢		1 50		
			\$20 55		
	Flat Rate:				
	47' @ 50¢		\$23 50		
	No trench repairs				
	Labor				

Hadley Press, Inc., Lexington

DATE _____

TOWN OF LEXINGTON—BOARD OF PUBLIC WORKS

WATER DIVISION

The undersigned applies for a supply of water at No. _____ St. and hereby agrees to comply with the rules and regulations as now, or at any future time, established by the Board of Selectmen.

Am't. of Estimate \$ _____


Owner _____

Am't. Paid \$ _____

Address _____

Builder _____

Sketch of Service Here

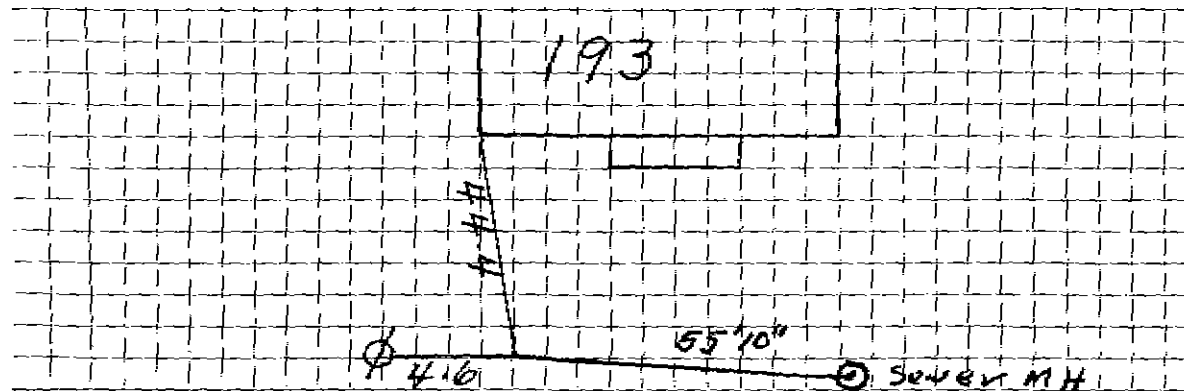

Connection made in _____ Street.

Work completed _____ 19

Remarks: