

Name Moore Construction Company

Service No. ~~86~~ 917

Address 60 Bow Street, Woburn, Mass.

194 Follen Road

Location 194 Follen Road

Kind of Pipe

Size

Size of Main

~~Repair~~ Renewal—New Service

Location

Date  
1941

Material

Amount

Total

Date

Amount

June 4

4 hrs. @ 60¢

2 40

10% Overhead

24

2 64

30' 3/4" C. Tubing @ 19¢

15 20

1 3/4" C. S. & W.

2 25

1 3/4" C. Union (3 part)

1 00

Trucking- 1 hr.

75

Trench repairs

13 16

35 00

May 19, 1941 Deposited

35 00

Labor

DATE April 30, 1941

# TOWN OF LEXINGTON—BOARD OF PUBLIC WORKS

## WATER DIVISION

The undersigned applies for a supply of water at No. 194 Follen Road St. and hereby agrees to comply with the rules and regulations as now, or at any future time, established by the Board of Selectmen.

Am't. of Estimate \$ \_\_\_\_\_


Owner J. Howard Atkins

Am't. Paid \$ \_\_\_\_\_

Address 6 Hillside Ave  
Lexington

Builder Moore Construction Co.  
by G. J. Moore  
60 Bow St., Roxbury  
Feb. 1675

Sketch of Service Here

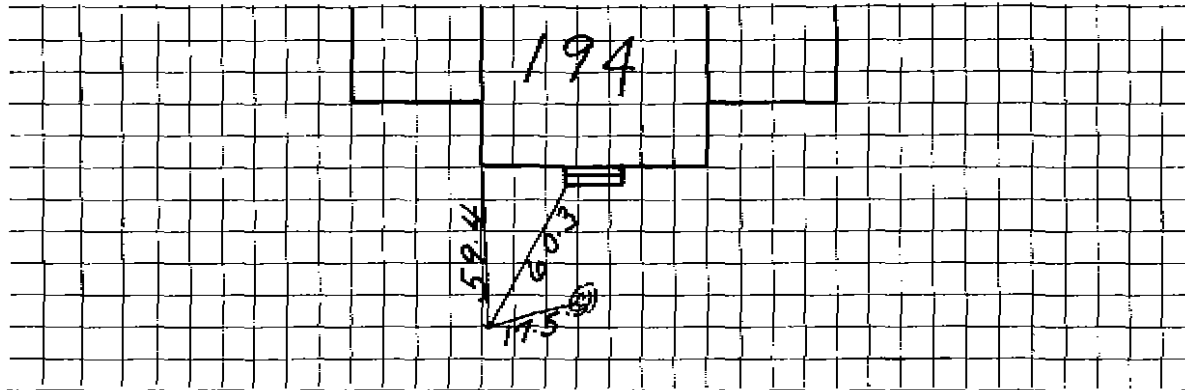

Connection made in \_\_\_\_\_ Street. Work completed \_\_\_\_\_ 19

Remarks: