

Deposit by :

Name James E. Rennie

Owner Dr. R. S. Juthe

Service No. ~~#~~ 919

Address 44 Emerson Road, Wellesley Hills, Mass.

197 Follen Road

Location

197 Follen Road

5206

5207

Kind of Pipe

Size

Size of Main

Repair—Renewal—New Service

Location

Date

Material

Amount

Total

Date

Amount

Dec. 26, 1940 9 hrs. @ 55¢ 4 95

Com 12.31.40 38 " " 60¢ 22 80

9 " " 70¢ 6 30

34 05

10% Overhead 3 41

48' 3/4" Copper tubing @ 19¢ 9 12

1 3/4" C.S. & W. 2 25

2 3/4" C.Unions (3 part) @ 90¢ 1 80

1 hr. compressor 3 00

3 hrs. trucking @ 75¢ 2 25

Trench repairs 9 00

64 88

December 9, 1940 Deposited

Dec 31, 1940 Refund

100 00

35 12

64 88

Labor

DATE 12-14-40

TOWN OF LEXINGTON—BOARD OF PUBLIC WORKS
WATER DIVISION

The undersigned applies for a supply of water at No. 197 Jollen Rd St. and hereby agrees to comply with the rules and regulations as now, or at any future time, established by the Board of Selectmen.

Am't. of Estimate \$ Town

Owner

Dr R.S. Jathe

Am't. Paid \$ _____


Address

23 Mayflower Rd
Lexington

Builder

James C. Merrill
447 Emerson Rd. Belvidere, Vt.

Sketch of Service Here

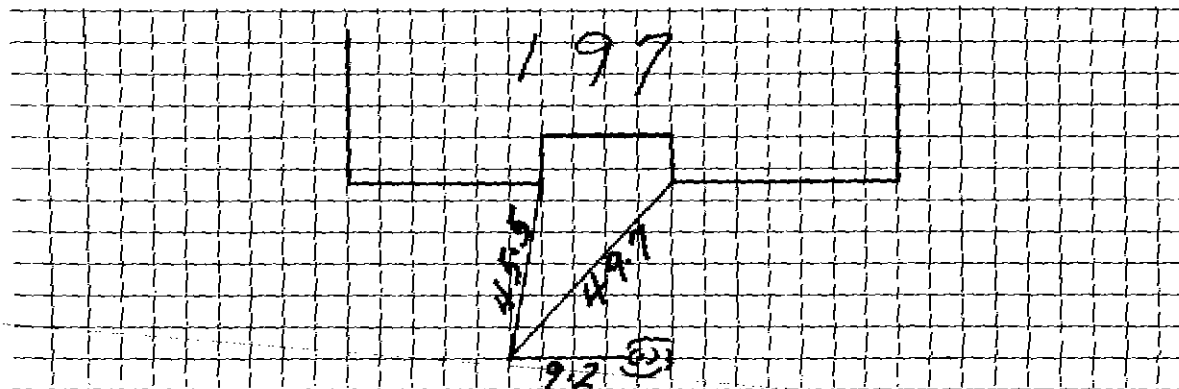

Connection made in _____ Street.

Work completed _____ 19____

Remarks: