

Order:   
 Name: Ward McKenzie

Owner: Kenneth Clarke  
 Service No. ~~4~~ 920

Address: 15 West Street, Marblehead, Mass.  
 198 Follen Road

Location: 198 Follen Rd .,

Kind of Pipe: \_\_\_\_\_ Size: \_\_\_\_\_ Size of Main: \_\_\_\_\_

~~Repair~~ ~~Renewal~~ New Service

Location

Date	Material	Amount	Total	Date	Amount
1941					
June 9	4 hrs. @ 60¢	2 40		May 31 1941	55 00
Com 6/30/41	10% Overhead	24	2 64	July 2 1941	14 06
	70' 3/4" Copper tubing @ 19¢	13 30			40 94
	1 3/4" C.S.& W.	2 25			
	1 3/4" Union (3 part)	1 00			
	1 3/4" Bushing	25			
	Trucking - 2 hrs. @ 75¢	1 50			
	Trench repairs	20 00			
			40 94		
	<b>Labor</b>				

Hadley Press, Inc., Lexington

DATE May 21, 1941

TOWN OF LEXINGTON—BOARD OF PUBLIC WORKS

WATER DIVISION

The undersigned applies for a supply of water at No. 198 <sup>Lot 58A.</sup> Fallen Road. St. and hereby agrees to comply with the rules and regulations as now, or at any future time, established by the Board of Selectmen.

Am't. of Estimate \$ (50 = ...)


Owner Kenneth Glarke

Am't. Paid \$ \_\_\_\_\_

Address Lexington

Builder W. West

Sketch of Service Here

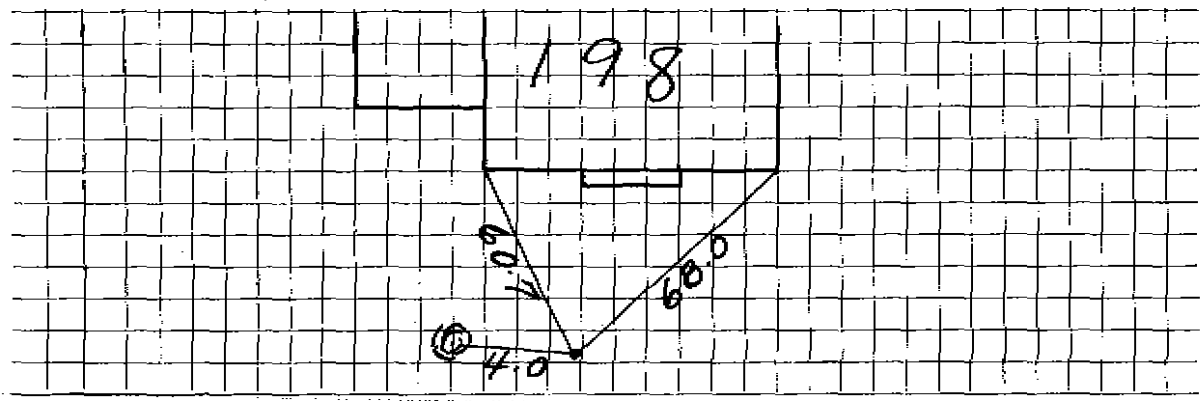

Connection made in \_\_\_\_\_ Street. Work completed \_\_\_\_\_ 19

Remarks: