

Name Paul E. Wilson
 Address Oakley Country Club, Watertown, Mass.
 199 Follen Road

Service No. ~~42~~ 921
 #4979

Location 199 Follen Road

Kind of Pipe Size Size of Main

~~Repair~~ ~~Renewal~~ — New Service

Location

Date	Material	Amount	Total	Date	Amount
------	----------	--------	-------	------	--------

June 10 1941	5½ hrs. @ 50¢	2 75		May 19, 1941 Deposited	37 00
Sum 6/30/41	20 " @ 60¢	12 00		July 10, 1941 Paid	4 92
	2 " @ 70¢	1 40	16 15		41 92
	10% Overhead		1 62		
	60' 3/4" Copper tubing @ 19¢		11 40		
	1 3/4" C. S. & W.		2 25		
	1 3/4" Bushing		25		
	Trucking- 3 hrs. @ 75¢		2 25		
	Trench repairs		8 00		
			41 92		

Labor

DATE May 27 1941

TOWN OF LEXINGTON—BOARD OF PUBLIC WORKS
WATER DIVISION

The undersigned applies for a supply of water at No. 199 Fallen St. and hereby agrees to comply with the rules and regulations as now, or at any future time, established by the Board of Selectmen.

Am't. of Estimate \$ 37.00


Owner Paul E. Wilson

Am't. Paid \$ 37.00

Address Oakley Country Club
Watertown, Mass.

Builder _____

Sketch of Service Here

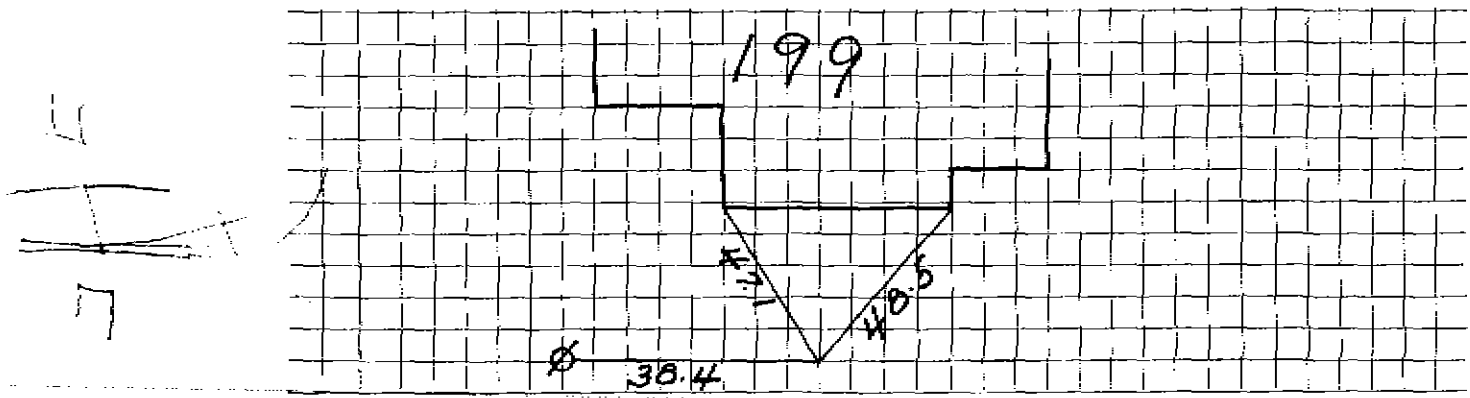

Connection made in _____ Street. Work completed _____ 19

Remarks: