

Name William Uichak
 Address 200 Follen Road
 Lexington, Mass.

Service No. 188 3426
 # 5948

Location 200 Follen Road

Kind of Pipe

Size

Size of Main

~~Repair~~ ~~Rebuild~~ — New Service

Com: 12/31/47

Location

Date	Material	Amount	Total	Date		Amount
12/13/47	Labor	2 95	2 95	12/17/47	Deposited	50 00
	10% Overhead		30	12/31/47	Refunded	5 55
	55' 3/4" Copper Tubing @ .26	14 30	14 30			44 45
	1 3/4" Cx 1/2" I.W.H. S&W	3 15	3 15		Non-Charge	
	2 hrs. Hired Shovel @ 7.00	14 00	14 00	12/23/47	Labor	8 81
	1 hr. Trucking		75		14' 3/4" Copper Tubing	
	Patching 9x3		9 00		1 3/4" Cx 3/4" C. Curb-cock	
			44 45		1 3/4" C. Corp. Cock	
					1 Box and Rod	
					1 1/2" Offset Tail Piece	
					1 1/2" Str. Tail Piece	
					3 hrs. Hired Shovel @ 7.00	
					3 hrs. Compressor	
					1 hr. Trucking	
	Labor					

DATE _____

TOWN OF LEXINGTON - BOARD OF PUBLIC WORKS
WATER DIVISION

The undersigned applies for a supply of water at No. St. and hereby agrees to comply with the rules and regulations as now, or at any future time, established by the Board of Selectmen.

Am't of Estimate \$.....


Owner

Am't Paid \$.....

Address

Builder

Sketch of Service Here

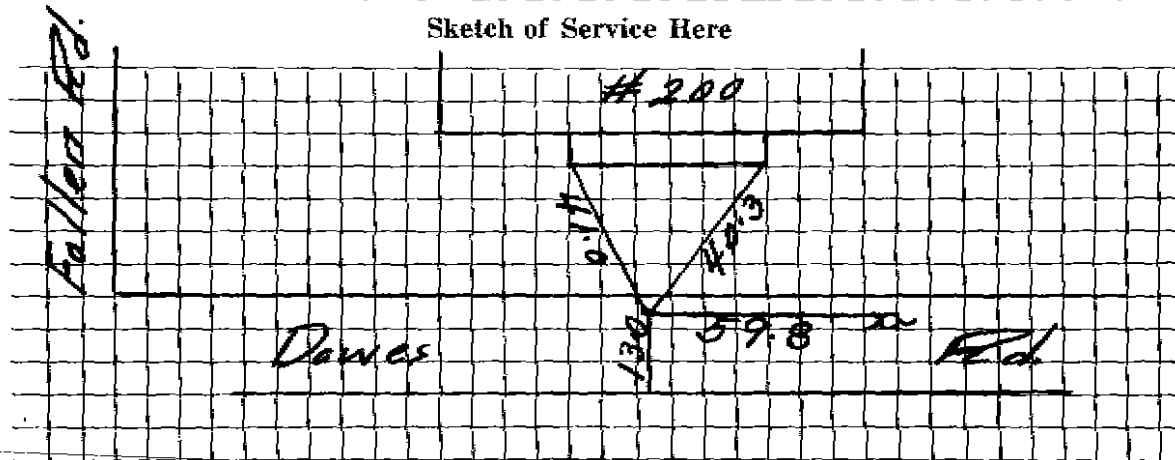

Connection made in Street.

Work completed19

Remarks: